
KANSAS

FORM 51 5M 2-38 TPCO. Ellis

Section 28 Township 11 Range 17-W

Well No. 4 Bemis "E"

Company Margay

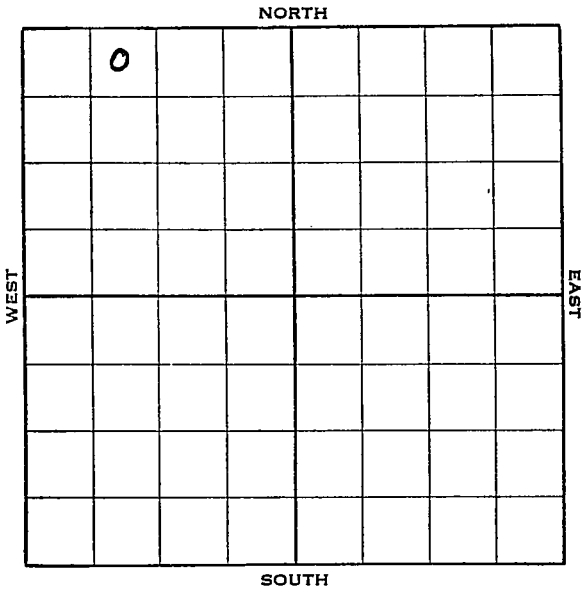

4

Form 252-A—5M—9-37 KANSAS Ellis

Sec. 28 Twp. 11 R. 17-W

Well No. #4 Bemis "E" Farm


Margay Company

330 Ft. from N. Line

Ft. from S. Line

Ft. from E. Line

990 Ft. from W. Line

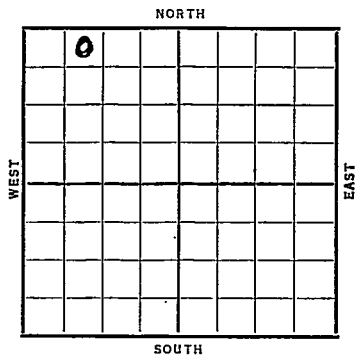

Elev. 1943

Date	REPORT
1938	
3/2	Location
3/11	R U R
3/18	15" @ 28'. Anhy 1168'.
	T.D. 1178'. Rng. 10".
3/25	10" @ 1174'. Drlg. 2252'.
4/1	Drlg. 3098'.
4/8	Arb. & 7" @ 3446'.
	RUST.
4/15	" "
4/20	7" @ 3446'.
	Arb. 3446'.
	T.D. 3448'.
	Potential 2186 bbls., Natural.
	COMPLETED

Form 26—1M Bks.—2-29

Ellis KANSAS

Map No. _____ Sec. 28 Twp. 11 R. 17W

Well No. 4 Bemis "E"

Margay Company

_____ Contractor

FIRST REPORT


330 NE NW NW Ft. from N. Line

_____ Ft. from S. Line

_____ Ft. from E. Line

990 Ft. from W. Line

SECTION PLAT

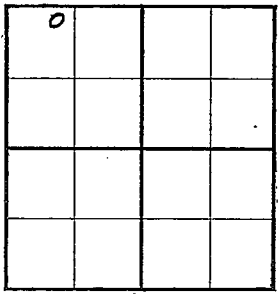

Location X

Rig up _____

Drilling and Remarks:

RECORD

Cased _____ in., _____ ft.

Sand _____

Gas _____

Oil _____

Total Depth _____

PRODUCTION

1st 24 hrs. Nat. _____

1st 24 hrs. after shot _____

Gas _____ Cu. Ft.

Dry Hole _____

Abandoned _____

Date

MAR 2 - 1938 19 H. D. Hatfield Scout

Form 26—1M Bks.—2-29

Ellis KANSAS

Map No. 71 Sec. 28 Twp. 11 R. 17W

Well No. 4 Bemis "E"

Margay Company

Contractor

COMPLETED

14 NE NW NW


330 Ft. from N. Line

Ft. from S. Line

Ft. from E. Line

990 Ft. from W. Line

SECTION PLAT

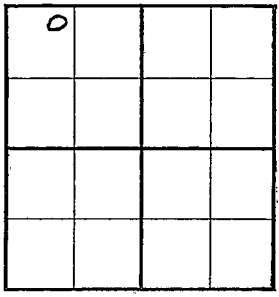

Location

Rig up

Drilling and Remarks:

Lot 2186

NW

RECORD

Cased 7 in., 3446 ft.

~~Sand~~ Arb 3446

Gas

Oil

Total Depth 3448

PRODUCTION

1st 24 hrs. Nat.

1st 24 hrs. after shot

Gas Cu. Ft.

Dry Hole

Abandoned

Date

APR 20 1938 19

H. D. Hatfield Scout