

KANSAS


FORM 51 5M 6-46 PETROL

Ellis County

Section 28 Township 11 Range 17W

Well No. 5 Bemis "F"

Company Sohio & Lario

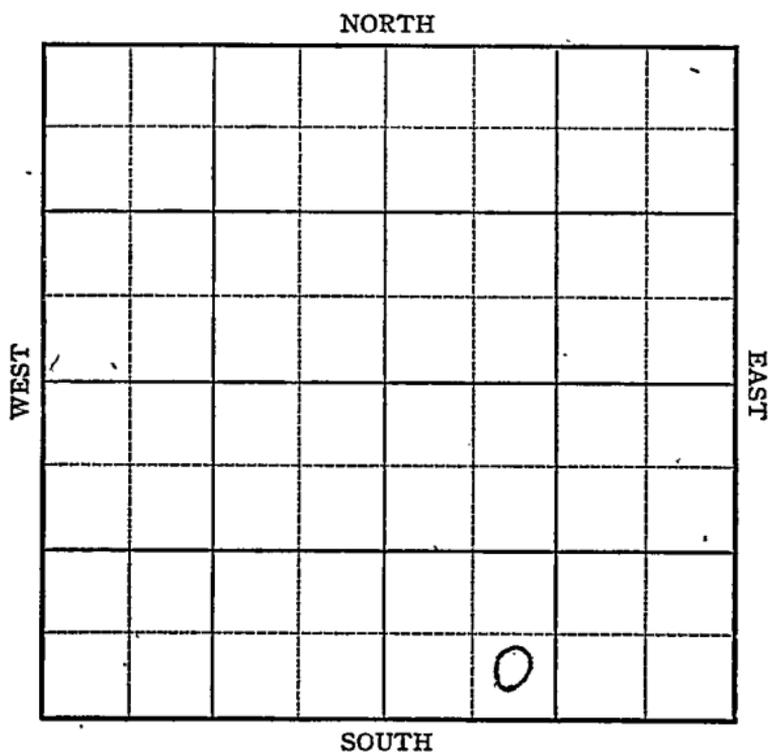

Sec. 28 Twp. 11 R. 17W

Well No. #5 Bemis "F" Farm

Sohio & Lario Company

Bemis


Ft. from N. Line

330 Ft. from S. Line

Ft. from E. Line

990 Ft. from W. Line

SE SW SE

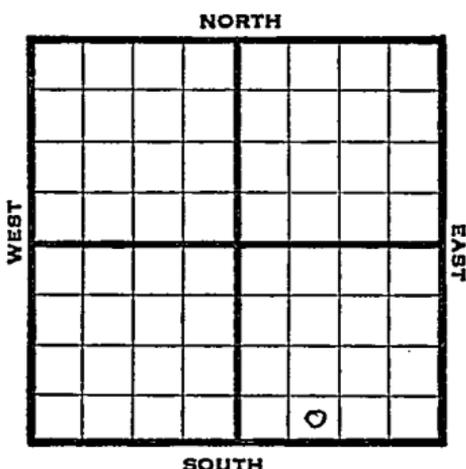

1946 1955 REPORT

- 8/7 Location
- 8/13 "
- 8/20 8" @ 1186 anhy 1175
Drlg 1805'
- 8/27 Drlg 3301'
- 9/5 Arb 3455'
TD 3457
5" @ 3455 RUST.
- 9/10 TD 3461
Swb 95 oil PH
- 9/18 " "
- 9/24 " "
- 10/1 500 acid
- 10/8 " "
- 10/16 Arb 3455'
5" @ 3455'
500 Acid
TD 3461'
Pump 854 POT
Grav. 33.9

COMPLETED

KANSAS

Kansas Pool Name BemisMap No. 71 Sec. 28 Twp. 11 R. 17WWell No. 5 Bemis "F"Sohio & Lario CompanyFIRST REPORT Contractor

SE SW SE

SECTION PLAT

			6

 Ft. from N. Line330 Ft. from S. Line Ft. from E. Line990 Ft. from W. LineEllis CountyLocation XRig up

Drilling and Remarks:

RECORD

Cased in., ft.Sand Gas Oil Total Depth

PRODUCTION

1st 24 hrs. Nat. 1st 24 hrs. after shot Gas Cu. Ft.Dry Hole Abandoned

Date

AUG 7 1946 19S. J. LEWIS Scout

Kansas

Map No. 71 Sec. 28 Twp. 11 R. 17W

Well No. 5 Bemis "F"

Sohio & Lario Company

COMPLETED

Contractor

SE SW SE

E. 1955

SECTION PLAT

_____ Ft. from N. Line

330 Ft. from S. Line

_____ Ft. from E. Line

990 Ft. from W. Line

Ellis County

RECORD

Location _____

Cased _____ in., _____ ft.

Rig up _____

Sand _____

Drilling and Remarks:

Gas _____

Oil _____

Total Depth 3461

Cor 8455
5108455
500 acid
Pump 55408

PRODUCTION

1st 24 hrs. Nat. _____

1st 24 hrs. after shot _____

Gas _____ Cu. Ft.

Dry Hole _____

Abandoned _____

0398

Date

OCT 16 1946 19

S. J. LEWIS Scout