


Section 28 Township 11 Range 17-W

Well No. #15 F A Bemis

Company Texas

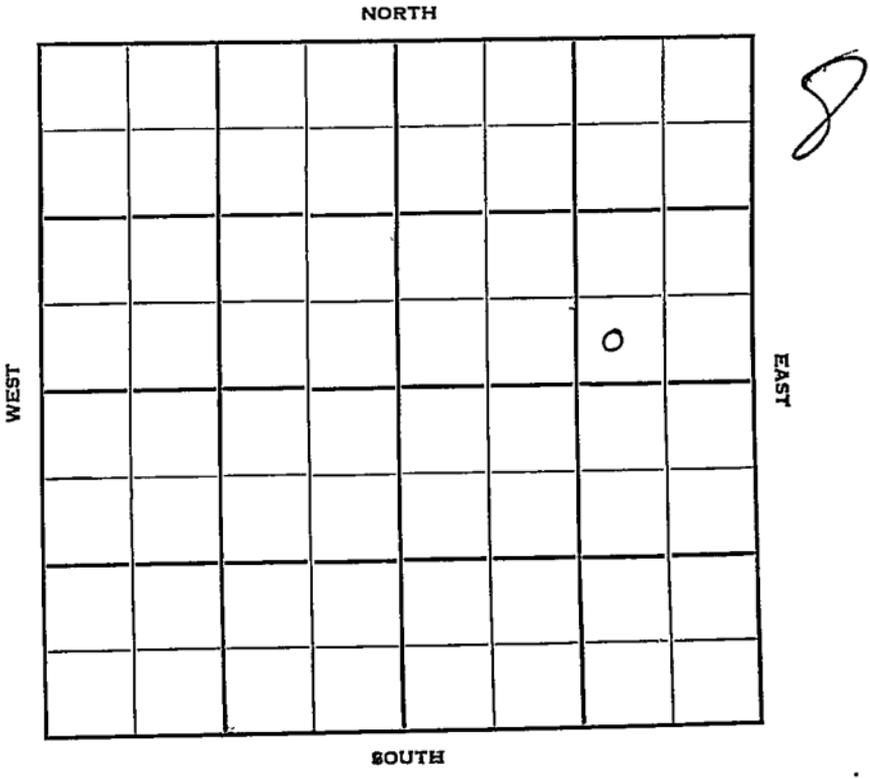

Sec. 28 Twp. 11 R. 17-W

Well No. #15 F. A. Bemis Farm

Texas Company

Bemis-Shutts Contractor


\_\_\_\_\_ Ft. from N. Line

330 Ft. from S. Line

990 Ft. from E. Line

\_\_\_\_\_ Ft. from W. Line

SW SE NE

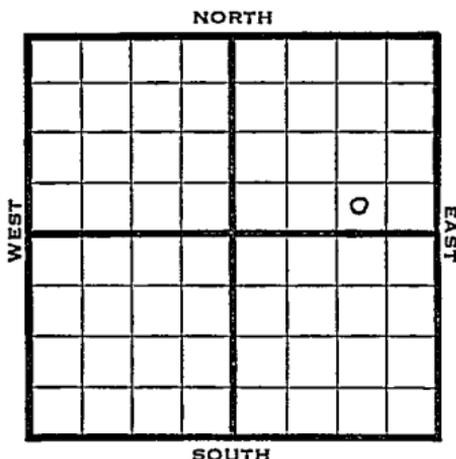

1950

Elev 1969

REPORT

7/19 Location

8/23 10" @ 1138

Heeb 3139

Lans 3194

Simp 3470

Arb 3476

DST 3454-75 opn 2 hr sec 210' o&gem

TD 3525

5" @ 3524

5/3516-18, 13/3514-17, 13/3508-11

16/3501-05 S/7 boph

300 A S/15 bo 15 hwph P/129 bo 155 bw

16 hr,

Comp 205 bopd

34 Grav

Completed

**COMPLETED**

County Ellis State Kansas

Sec. 28 (Blk. 11) (Sur. 17W) (Twp.) (Rge.) Map No.

Operator Texas

Well No. 15 Farm F. A. Bemis

Elev. 1969 Location SW SE NE


330 Ft. From S Line NE  
990 Ft. From E Line Quarter

1st. Report \_\_\_\_\_

Completion AUG 23 1950

Remarks \_\_\_\_\_

Bemis-Schutts Pool

Spudding Date \_\_\_\_\_

Drig. Data Oil well TD 3525

10" @ 1138 Heeb. 3139 Lans. 3194

Simp. 3470 Arb. 3476 DST 3454-75

open 2 hr. Rec. 210' o & gcm TD 3525

5" @ 3524 5/ 3516-18 13/ 3514-17

13/ 3508-11 16/ 3501-05 S/ 7 boph

300 A S/ 15 bo 15 bwph P/129 bo 155 bw

16 hr. Comp. 205 bopd 34 gravity

J. E. TYRA

Map No. \_\_\_\_\_ Sec. 28 Twp. 11 R. 17WWell No. 15 F. A. Bemis

\_\_\_\_\_ Texas \_\_\_\_\_ Company

\_\_\_\_\_ Contractor

SW SE NE

## SECTION PLAT

\_\_\_\_\_ Ft. from N. Line

330 Ft. from S. Line990 Ft. from E. Line

\_\_\_\_\_ Ft. from W. Line



Ellis County

Location X

Rig up \_\_\_\_\_

Drilling and Remarks:

## RECORD

Cased \_\_\_\_\_ in., \_\_\_\_\_ ft.

Sand \_\_\_\_\_

Gas \_\_\_\_\_

Oil \_\_\_\_\_

Total Depth \_\_\_\_\_

## PRODUCTION

1st 24 hrs. Nat. \_\_\_\_\_

1st 24 hrs. after shot \_\_\_\_\_

Gas - \_\_\_\_\_ Cu. Ft.

Dry Hole: \_\_\_\_\_

Abandoned \_\_\_\_\_

Date

JUL 19 1950

19

J. E. TYRA

Scout