Ellis

FORM 51 IOM 12-46 PETROL


KANSAS

28

Section 28 Township 11 Range 17W

Well No. 14 Bemis "A"

Company Texas

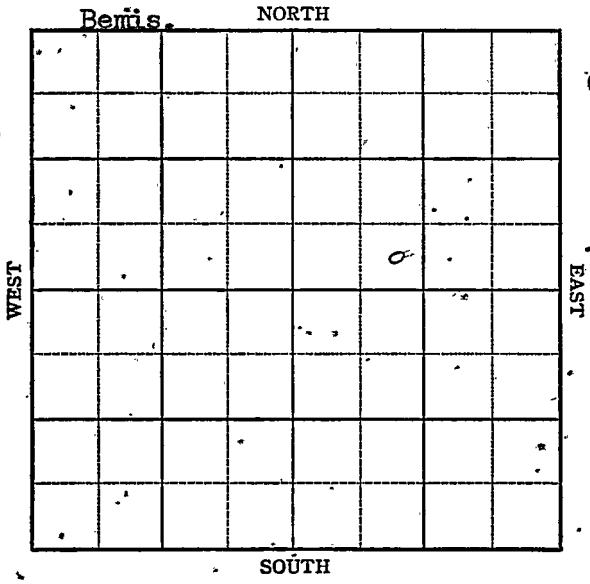


FORM 252-A
5M 12-46 PETROL

KANSAS Ellis county ✓

Sec. ~~20~~ 28 Twp. 11 R. 17W

Well No. 14 Bemis "A" Farm

Texas Company

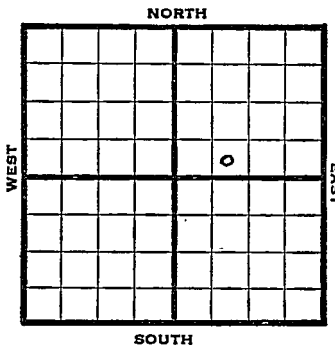

_____ Ft. from N. Line

330 Ft. from S. Line

_____ Ft. from E. Line

990 Ft. from W. Line

SE SW NE

1947	Elev. 1976' REPORT
5/7	Location
5/13	RUR
5/20	8" @ 1216' Drlg 1850'
5/27	Drlg. 3260'
6/3	Arbuckle 3474 TD TD 3646 5" @ 3643 RUST
6/10	" "
6/17	" "
6/24	51 shots 3468-3478 swt 15 oil PH 6 hrs.
7/2	Arb. 3474' 5" @ 3643' Perf. Pump 417 Oil -/ 10% water Pot 36.8 Gr. TD 3646'

COMPLETED

Form 26 200 Bks. 10-46 Petrol

Bemis Pool

Kansas

Map No. K-71 Sec. 28 Twp. 11 R. 17W


Well No. 14 Bemis "A"

Texas Company

FIRST REPORT Contractor

SE SW NE

SECTION PLAT

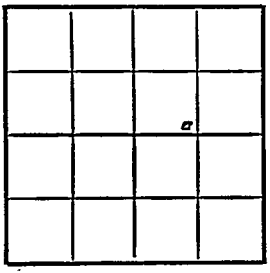

Ft. from N. Line

330 Ft. from S. Line

Ft. from E. Line

990 Ft. from W. Line

Ellis
Ellis County

Location X

Rig up

Drilling and Remarks:

RECORD

Cased in., ft.

Sand

Gas

Oil

Total Depth

PRODUCTION

1st 24 hrs. Nat.

1st 24 hrs. after shot

Gas Cu. Ft.

Dry Hole

Abandoned

Date

MAY 7 1947 19

S. J. LEWIS Scout

Form 26 200 Bks. 10-46 Petrol

Bemis Pool

Kansas

Map No. 71 Sec. 28 Twp. 11 R. 17W


Well No. 14 Bemis "A"

Texas Company

CORRECTION Contractor

SE SW NE

SECTION PLAT

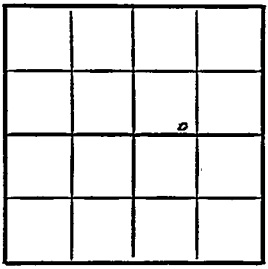

____ Ft. from N. Line

330 Ft. from S. Line

____ Ft. from E. Line

990 Ft. from W. Line

Ellis County

Location

Rig up

Drilling and Remarks:

Reported
20-11-17W

RECORD

Cased ____ in., ____ ft.

Sand

Gas

Oil

Total Depth

PRODUCTION

1st 24 hrs. Nat.

1st 24 hrs. after shot

Gas Cu. Ft.

Dry Hole

Abandoned

Date

JUN 25 1947 19 S. J. LEWIS Scout

Form 26 200 Bks. 10-46 Petrol

Bemis Pool

Kansas

Map No. 71 Sec. 28 Twp. 11 R. 17W

Well No. 14 Bemis "A"


Texas Company

COMPLETE Contractor

SE SW NE

E.1.1876

SECTION PLAT

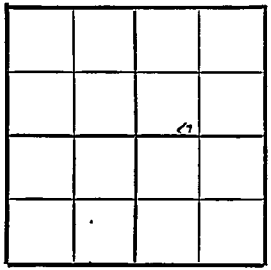

____ Ft. from N. Line

330 Ft. from S. Line

____ Ft. from E. Line

990 Ft. from W. Line

Ellis County

Location

Rig up

Drilling and Remarks:

Ran 3474'
5" @ 3643'
Perf.
Pump #17 oil + 10% Water Pay
86 BO

RECORD

Cased ____ in., ____ ft.

Sand

Gas

Oil

Total Depth 3646

PRODUCTION

1st 24 hrs. Nat.

1st 24 hrs. after shot

Gas ____ Cu. Ft.

Dry Hole

Abandoned

Date

JUL 2 1947 19

S. J. LEWIS Scout