


KANSAS

Ellis County

Section 28 Township 11 Range 17W

Well No. #6 Bemis "A"

Company York State

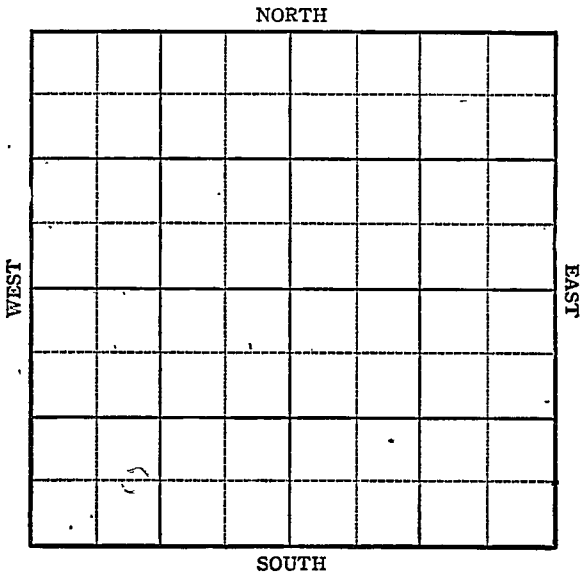

13

KANSAS

Ellis County

Sec. 28 Twp. 11 R. 17W

Well No. #6 Bemis "A" Farm

York State Company


Bemis

_____ Ft. from N. Line

660 Ft. from S. Line

_____ Ft. from E. Line

990 Ft. from W. Line

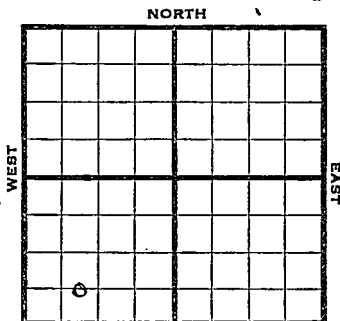

C E L SW SW *Edwards* 1942 SOUTH

1944

R E P O R T

- 10/11 Drk.
- 10/18 Surface hole
- 10/25 anhy 1140
8" @ 1203
Drlg. 2130
- 11/2 Drlg. 3030'
- 11/8 Simp. sd 3446
Arb 3450
5" @ 3451
TD 3463 RUST
- 11/16 1000 acid
- 11/22 Arb. 3450
5" @ 3451
1000 acid.
TD 3463
Pump 125 oil plus 50 wtr Pot.
34.6 Gravity

COMPLETED

Pool Name BemisMap No. 7/15 Sec. 23 Twp. 11 R. 17WWell No. 6 Bemis "A"York State

Company

FIRST REPORT

Contractor

C E L SW SW

SECTION PLAT

Ft. from N. Line

660 Ft. from S. Line

Ft. from E. Line

990 Ft. from W. Line

Ellis County

Location

Rig up

Drilling and Remarks:

Derrick

RECORD

Cased _____ in., _____ ft.

Sand _____

Gas _____

Oil _____

Total Depth _____

PRODUCTION

1st 24 hrs. Nat. _____

1st 24 hrs. after shot _____

Gas _____ Cu. Ft.

Dry Hole _____

Abandoned _____

Date

OCT 1 1 1944 19S. J. LEWIS Scout

Pool Name Bemis

Map No. 71 Sec. 28 Twp. 11 R. 17W

Well No. 6 Bemis "A"

York State Company

COMPLETED

Contractor

C E L SW SW

SECTION PLAT

 Ft. from N. Line

660 Ft. from S. Line

 Ft. from E. Line

990 Ft. from W. Line

Ellis

Location

Rig up

Drilling and Remarks:

*Cor 83450
5" @ 8451
1000 acid
Pump 125 oil +
50 Water Ad.
34 1/2*

RECORD

Cased in., ft.

Sand

Gas

Oil 4 5

Total Depth 8463

PRODUCTION

1st 24 hrs. Nat.

1st 24 hrs. after shot

Gas Cu. Ft.

Dry Hole

Abandoned

Date

NOV 22 1944 19

S. J. LEWIS Scout