


Section 28 Township 11- Range 17-W

Well No. 8 Bemis

Company Wentz

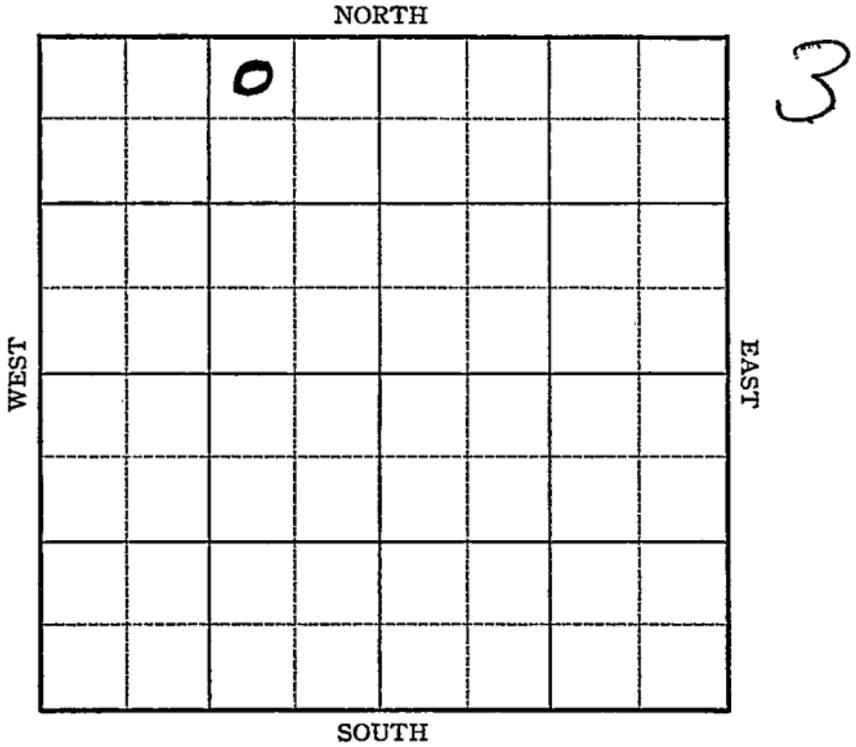

KANSAS

Ellis

Sec. 28 Twp. 11 R. 17-W

Well No. #8 Bemis Farm

Wentz Company


330 Ft. from N. Line

 Ft. from S. Line

990 Ft. from E. Line

 Ft. from W. Line

Elev. 1909

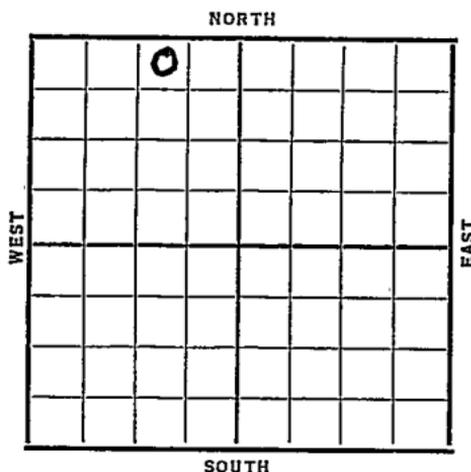

Date	REPORT
1937	
9/1	R U R
9/10	S. H.
9/17	15" @ 40'. Anhy 1120'.
	10" @ 1139'. Drlg. 2780'.
9/24	Drlg. 3408' correct ed)
	No show reported.
10/2	Sil. & 7" @ 3409'. T.D. 3417'.
	2800' oil in 1 hour.
10/6	7" @ 3409'.
	Sil. 3409'.
	T.D. 3417'.
	Potential 2646 bbls. Nat.
	COMPLETED

Ellis **KANSAS**

Map No. _____ Sec. 28 Twp. 11 R. 17w

Well No. S. Bemis

Bentley Company
 _____ Contractor

FIRST REPORT

SECTION PLAT

	0		

330 Ft. from N. Line
 _____ Ft. from S. Line
990 Ft. from E. Line
 _____ Ft. from W. Line

RECORD

Cased _____ in., _____ ft.
 Sand _____
 Gas _____
 Oil _____
 Total Depth _____

PRODUCTION

1st 24 hrs. Nat. _____
 1st 24 hrs. after shot _____
 Gas _____ Cu. Ft.
 Dry Hole _____
 Abandoned _____

Location _____

Rig up _____

Drilling and Remarks:

A.U.R.

Date

SEP 1 1937 19

H. D. Hatfield Scout

RAY

Returned	<i>[Signature]</i>
Cards	<i>[Signature]</i>
Tracing	<i>[Signature]</i>
France Map	<i>[Signature]</i>
Scarborough Map	<i>RAY</i>
Moody Map	
Scarborough Plat Book	
Moody Plat Book	

Map No. _____ Sec. 28 Twp. 11 R. 17WWell No. 8 BemisWentz

Company

Contractor

COMPLETED**SECTION PLAT**

	0		

NW NE NW

330 Ft. from N. Line

_____ Ft. from S. Line

990 Ft. from E. Line

_____ Ft. from W. Line

Location _____

Rig up _____

Drilling and Remarks:

POT-2646Nat.**RECORD**Cased 7 in., 3409 ft.Sand sil 3409

Gas _____

Oil _____

Total Depth 3417**PRODUCTION**

1st 24 hrs. Nat. _____

1st 24 hrs. after shot _____

Gas _____ Cu. Ft.

Dry Hole _____

Abandoned _____

Date

OCT - 6 193719H. D. Hatfield Scout

RAY

Returned	<i>Ray</i>
Cards	<i>Ray</i>
Tracing	<i>Ray</i>
Frames	<i>Ray</i>
Geographic Maps	<i>Ray</i>
Moody Plat	<i>Ray</i>
Scarborough Plat Book	
Moody Plat Book	