


Ellis

Section 28 Township 11 Range 17-W

Well Number 4 - Bemis

Company Wentz

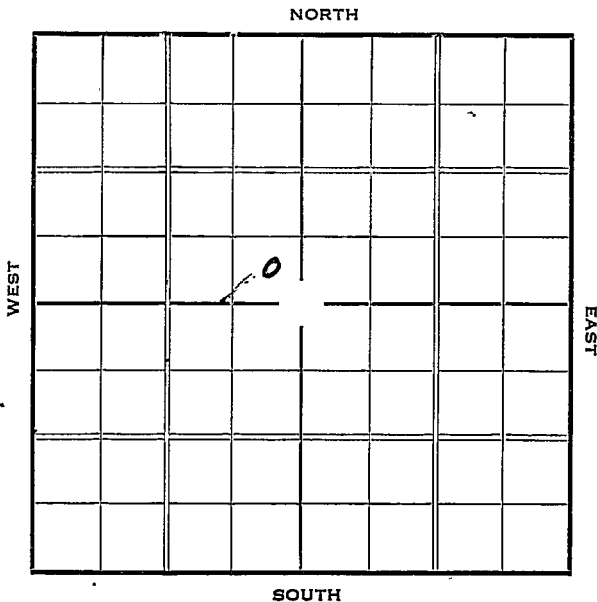

Ellis KANSAS

Map No. _____ Sec. 28 Twp. 11 R. 17^W

Well No. 4 - Bemis

Wentz Company
Contractor

FIRST REPORT

SECTION PLAT

330 Ft. from N. Line
330 Ft. from S. Line
330 Ft. from E. Line
_____ Ft. from W. Line

	0		

Location _____

RECORD

Rig up _____

Cased _____ in., _____ ft.

Drilling and Remarks:

Sand _____

R. U. R.

Gas _____

Oil _____

Total Depth _____

PRODUCTION

1st 24 hrs. Nat. _____

1st 24 hrs. after shot _____

Gas _____ Cu. Ft.

Dry Hole _____

Abandoned _____

Date

~~JUL~~ 11 1937 19

H. D. Hatfield Scout

Ellis KANSAS

Map No. _____ Sec. 28 Twp. 11 R. 17W

Well No. 4 - Bennis

Wentz Company

Contractor

COMPLETED

SECTION PLAT

_____ Ft. from N. Line

330 Ft. from S. Line

330 Ft. from E. Line

_____ Ft. from W. Line

		0	

Location _____

Rig up _____

Drilling and Remarks:

P. - 406/4
406/4

pot - 2434

RECORD

Cased 7 in., 3416 ft.

Sand 511 3416

Gas _____

Oil _____

Total Depth 3429

PRODUCTION

1st 24 hrs. Nat. _____

1st 24 hrs. after shot _____

Gas _____ Cu. Ft.

Dry Hole _____

Abandoned _____

Date

AUG 18 1937

H. D. Hatfield Scout