
Ellis

FORM 51 5M 2-38 TPCO. KANSAS

Section 28 Township 11 Range 17-W

Well No. #2 Bemis "E"

Company Margay Oil

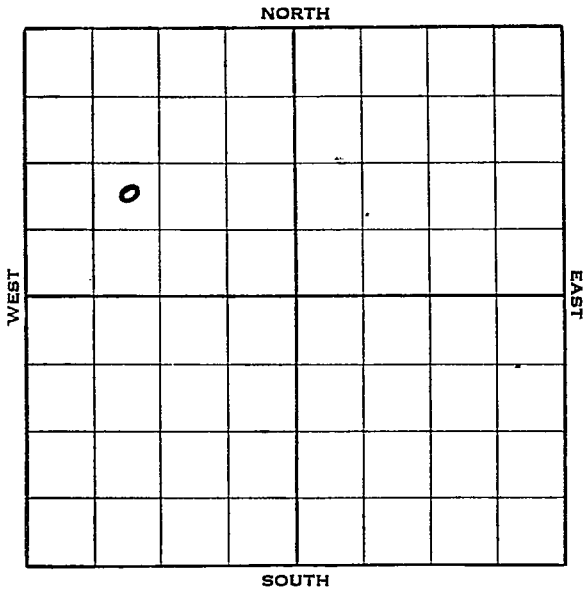


5

FORM 252-A 5M 1-38 KANSAS Ellis

Sec. 28 Twp. 11 R. 17-W

Well No. #2 Bemis "E" Farm

Margay Oil Company

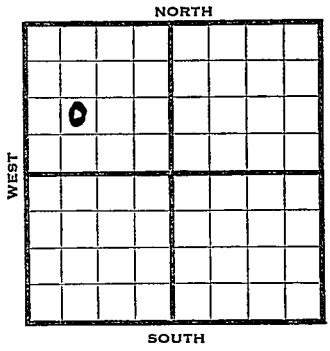

_____ Ft. from N. Line

990 Ft. from S. Line

_____ Ft. from E. Line

990 Ft. from W. Line

Elev. 1969

1938	REPORT
4/20	Location
4/29	R. R.
5/6	Anhy 1197'. 12" @ 1203'. WOC.
5/12	Drlg. 2350'.
5/20	" "
5/27	Arb. 3469-76' T.D. 7" @ 3469'.
	2600' oil.
6/3	" " " "
6/10	1500 acid. Testing.
	T.D. 3476'.
6/15	7" @ 3469'.
	Arb. 3469'.
	T.D. 3476'.
	1500 acid.
	Potential 840 bbls.
	COMPLETED

Form 26—1M Bks.—2-29

Ellis KANSAS

Map No. 71 Sec. 28 Twp. 11 R. 17W

Well No. 2 Bemis "E"

Margay Oil Company

Contractor

FIRST REPORT

NE SW NW


_____ Ft. from N. Line

990 Ft. from S. Line

_____ Ft. from E. Line

990 Ft. from W. Line

SECTION PLAT

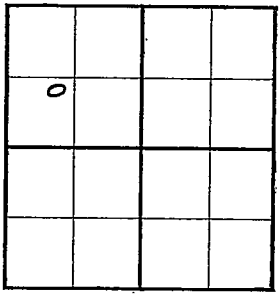

Location X

Rig up

Drilling and Remarks:

RECORD

Cased _____ in., _____ ft.

Sand

Gas

Oil

Total Depth

PRODUCTION

1st 24 hrs. Nat.

1st 24 hrs. after shot

Gas _____ Cu. Ft.

Dry Hole

Abandoned

Date

APR 20 1938 19 H. D. Hatfield Scout

Form 26—1M Bks.—2-29 Ellis KANSAS

Map No. 71 Sec. 28 Twp. 11 R. 17W

Well No. 2 Bemis "E"

Margay Oil Company

Contractor

COMPLETED

NE SW NW


Ft. from N. Line

990 Ft. from S. Line

Ft. from E. Line

990 Ft. from W. Line

SECTION PLAT

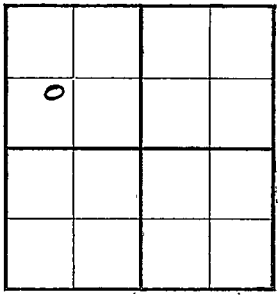

Location

Rig up

Drilling and Remarks:

1500 Acid

POT 840

RECORD

Cased 7 in., 3469 ft.

~~Sand~~ Arb 3469

Gas

Oil

Total Depth 3476

PRODUCTION

1st 24 hrs. Nat.

1st 24 hrs. after shot

Gas Cu. Ft.

Dry Hole

Abandoned

Date

JUN 15 1938 19 H. D. Hatfield Scout