
Ellis County Kansas

Form 51-5M 5-37 Petrol

Section 28 Township 11 Range 17W

Well No. 4 Bemis "D"

Company Margay

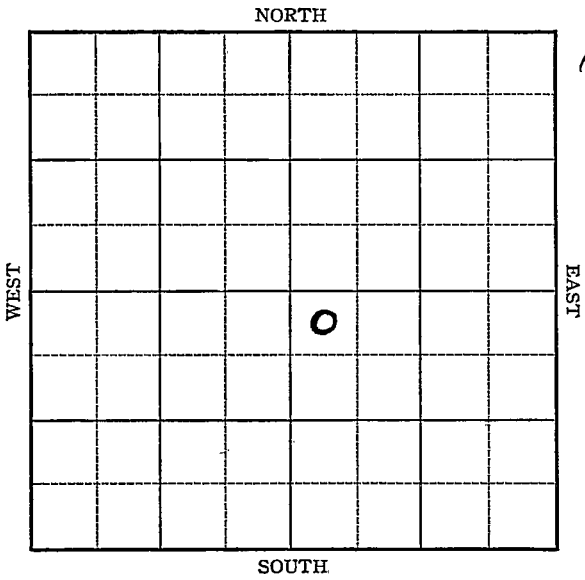

10

Form 252-A—5M—2-37—Palace KANSAS Ellis

Sec. 28 Twp. 11 R. 17-W

Well No. #4 Bemis "D" Farm


Margay Company

330 Ft. from N. Line

Ft. from S. Line

Ft. from E. Line

330 Ft. from W. Line

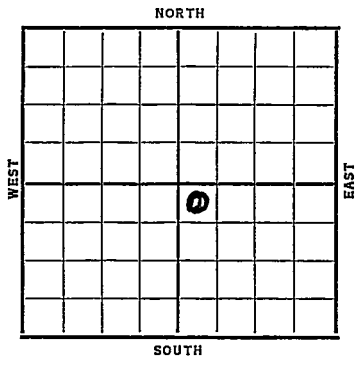

Elev. 1924

Date	REPORT
1937	
7/28	S. H.
8/6	15" @ 31'. Anhy 1149'. 10" @ 1154'.
	WOC.
8/13	Drlg. 2412'.
8/20	Drlg. 3120'.
8/28	Sil. & 7" @ 3424'. WOC.
9/1	7" @ 3424'.
	Sil. 3424'.
	T.D. 3429½'.
	Pot. 1046 bbls.
	COMPLETED

Form 26—1M Bks.—2-29 Ellis KANSAS

Map No. _____ Sec. 28 Twp. 11 R. 17W


Well No. 4- Bemis "D"

Margay Company

_____ Contractor

FIRST REPORT

SECTION PLAT

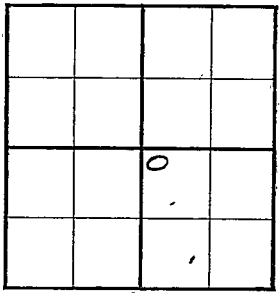

330 Ft. from N. Line

_____ Ft. from S. Line

_____ Ft. from E. Line

330 Ft. from W. Line

Location _____

Rig up _____

Drilling and Remarks:

S.H.

RECORD

Cased _____ in., _____ ft.

Sand _____

Gas _____

Oil _____

Total Depth _____

PRODUCTION

1st 24 hrs. Nat. _____

1st 24 hrs. after shot _____

Gas _____ Cu. F

Dry Hole _____

Abandoned _____

Date

JUL 28 1919

H. D. Hatfield

Form 26—1M Bks.—2-29 Ellis KANSAS

Map No. _____ Sec. 28 Twp. 11 R. 17 W


Well No. 4 - Bemis "D"

Margay Company

Contractor

COMPLETED

SECTION PLAT

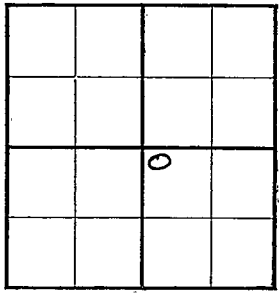

330 Ft. from N. Line

_____ Ft. from S. Line

_____ Ft. from E. Line

330 Ft. from W. Line

Location _____

Rig up _____

Drilling and Remarks:

Pot - 1046

RECORD

Cased 7 in., 3424 ft.

~~Sand~~ 511 3424

Gas _____

Oil _____

Total Depth 3429½

PRODUCTION

1st 24 hrs. Nat. _____

1st 24 hrs. after shot _____

Gas _____ Cu. Ft.

Dry Hole _____

Abandoned _____

Date

SEP 1 1937 19

H. D. Hatfield Scout