


Ellis county

Section 28 Township 11 Range 17-W

Well No. #6, Bemis "D"

Company Sohio

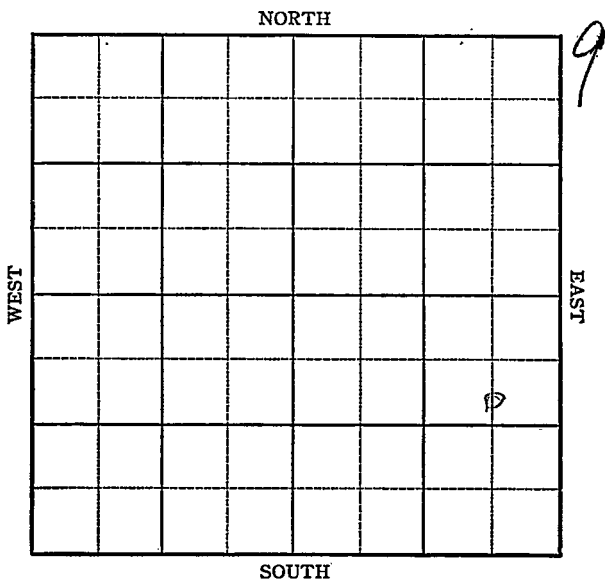

Sec. 28 Twp. 11 R. 17W

Well No. #6 Bemis "D" Farm

Sohio Company


Bemis

990 Ft. from N. Line

Ft. from S. Line

660 Ft. from E. Line

Ft. from W. Line

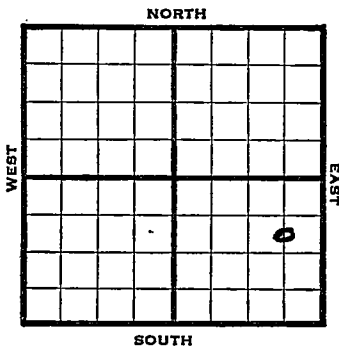

C S L NE SE

1946 Elv. ^{2000'} ~~1200'~~ REPORT

- 11/6 Location
- 11/12 "
- 11/20 "
- 11/27 "
- 12/3 Drlg 165'
- 12/10 8" @ 1233'
Drlg 2165'
- 12/17 Drlg 3455'
- 1947
- 1/4 Arb 3521'
TD 3 523
5" @ 3523, RUST
- 1/8 TD 3532'
Swb 5 oil PH
- 1/15 " "
- 1/22 Arb. 3521'
5" @ 3523'
TD. 3532'
5000' acid
Pump 106' pot.
Gravity 33⁰

COMPLETED

Map No. 71 Sec. 28 Twp. 11 R. 17W

Well No. 6 Bemis "D"

Sohio

Company

FIRST REPORT

Contractor

C S L NE SE

SECTION PLAT

990 Ft. from N. Line

_____ Ft. from S. Line

660 Ft. from E. Line

_____ Ft. from W. Line

			6

Ellis County

Location X

Rig up _____

Drilling and Remarks:

RECORD

Cased _____ in., _____ ft.

Sand _____

Gas _____

Oil _____

Total Depth _____

PRODUCTION

1st 24 hrs. Nat. _____

1st 24 hrs. after shot _____

Gas _____ Cu. Ft.

Dry Hole _____

Abandoned _____

Date

NOV 6 1946 19

S. J. LEWIS

Scout

Map No. 71 Sec. 28 Twp. 11 R. 17W

Well No. 6 Bemis "D"

Sohio Company

COMPLETE

Contractor

C S L NE SE

E12000
SECTION PLAT

990 Ft. from N. Line

 Ft. from S. Line

660 Ft. from E. Line

 Ft. from W. Line

Ellis County

RECORD

Location

Cased in., ft.

Rig up

Sand

Drilling and Remarks:

Gas

Oil

Total Depth 3532

Cr 3521

5" C 3523

5000 cu ft

Pump 106 Pk.

PRODUCTION

1st 24 hrs. Nat.

1st 24 hrs. after shot

Gas Cu. Ft.

Dry Hole

Abandoned

Date

JAN 22 1947 19

S. J. LEWIS Scout