KANSAS


FORM 51 5M 6-46 PETROL

Ellis county

Section 28 Township 11 Range 17 W

Well No. #3, Bemis "D"

Company Sohio

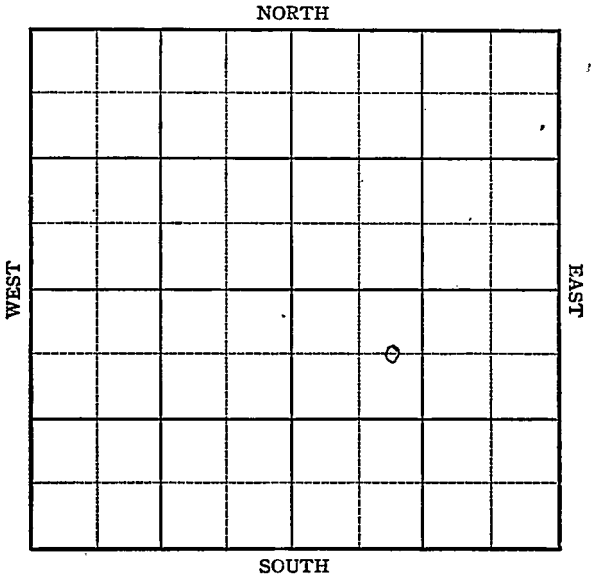

10

FORM 252-A
5M 12-45 PETROL

KANSAS

Ellis County

Sec. 28 Twp. 11 R. 17W

Well No. #3 Bemis "D" Farm

Sohio Company

Bemis


660 Ft. from N. Line

Ft. from S. Line

Ft. from E. Line

990 Ft. from W. Line

C E L NW SE

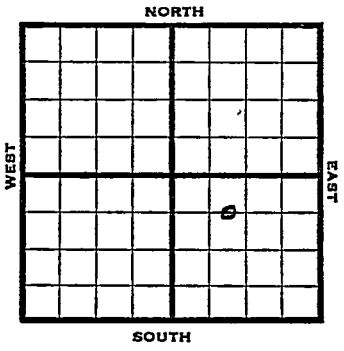

1946 1963 REPORT

9/18 Anhy 1183'
8" @ 1193'
Drlg 2080'

10/1 Arb 3473
3477 TD
5" @ 3474 RUST

10/8 Swb 23 oil PH 4 hrs

10/15 7400 off bottom

10/22 " "

10/30 Arb 3473'
5" @ 3474'
TD 3477'
Pump 660 POT
33 Grav.

COMPLETED

FORM 56 200 BKS. 1-44 PETROL

KANSAS Kansas Pool Name Bemis

Map No. 7 / Sec. 28 Twp. 11 R. 17W


Well No. 3 Bemis "D"

Sohio Company

FIRST REPORT Contractor

C E L NW SE

SECTION PLAT

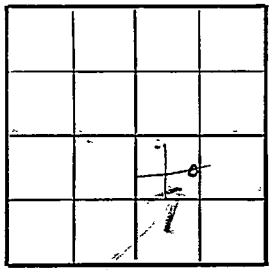

660 Ft. from N. Line

Ft. from S. Line

[illegible] Ft. from E. Line

990 Ft. from W. Line

Ellis County

Location

Rig up

Drilling and Remarks:

Anhy 1183'

8"@ 1193'

2080'

RECORD

Cased in., ft.

Sand

Gas

Oil

Total Depth

PRODUCTION

1st 24 hrs. Nat.

1st 24 hrs. after shot

Gas Cu. Ft.

Dry Hole

Abandoned

Date

SEP 1 8 1946 19

S. J. LEWIS Scout

Form 26 200 Bks. 10-46 Petrol

Bemis Pool

Kansas

Map No. 7 / Sec. 28 Twp. 11 R. 17W

Well No. 3 Bemis "D"


Sohio Company

COMPLETED Contractor

C E L NW SE

E. 1.1963

SECTION PLAT

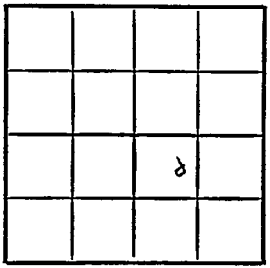

660 Ft. from N. Line

Ft. from S. Line

Ft. from E. Line

990 Ft. from W. Line

Ellis County

Location

Rig up

Drilling and Remarks:

OR @ 3473

5' @ 3474

Prod 660 BX

33° Gr

RECORD

Cased in., ft.

Sand

Gas

Oil

Total Depth 3477

PRODUCTION

1st 24 hrs. Nat.

1st 24 hrs. after shot

Gas Cu. Ft.

Dry Hole

Abandoned

Date

OCT 30 1946 19

S. J. LEWIS Scout