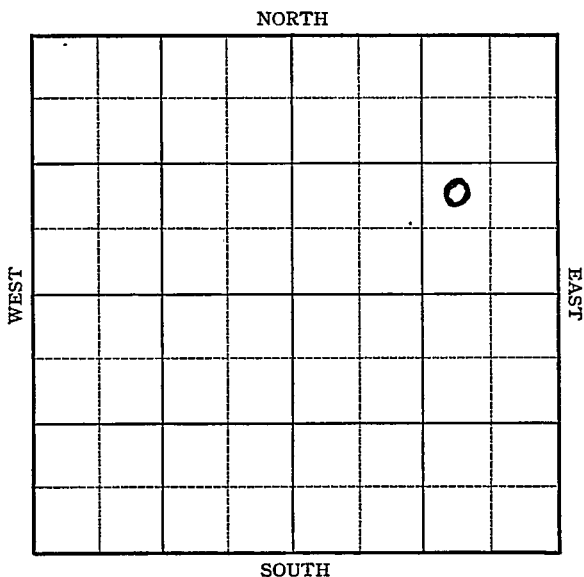


Section 28 Township 11 Range 17-WWell No. #12 Bemis "A"Company Texas

KANSAS

Ellis

Sec. 28 Twp. 11 R. 17 W

Well No. 12 - Bemis "A" Farm _____
Texas _____ Company _____


_____ Ft. from N. Line

990 Ft. from S. Line

990 Ft. from E. Line

Ft. from W. Line

Elev. 1995

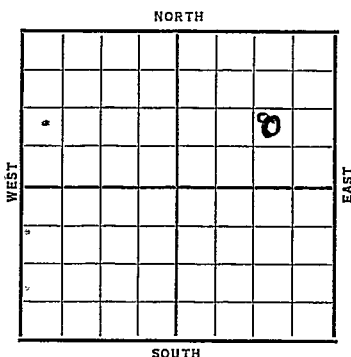

Date	REPORT
1937	
8/11	Location
8/20	B.R.R.
8/28	15" @ 30'. Drlg. 1104'.
9/3	Drlg. 2350'.
9/10	Drlg. 3043'.
9/17	Drl g. 3354'.
9/24	7" @ 3516 $\frac{1}{2}$ '. Sil. 3516'.
	T.D. 3526'. RUST.
	No show reported.
10/2	" " "
10/8	" " "
10/15	T.D. 3543'. 1000' oil 6 hrs. 1000 acid. Pumped 210 B.O. 24 hrs. Reacidizing.
	OVER

1937

10/20 15" @ 30'.

7" @ 3516 $\frac{1}{2}$ '.

Sil. 3516'.

T.D. 3543'.

1000 acid.

4000 acid.

Potential 787 bbls.

COMPLETED

KANSAS

Map No. _____ Sec. 28 Twp. 11 R. 17 WWell No. 12- Bemis "A"Texas Company

Contractor _____

FIRST REPORT

SECTION PLAT

			0

_____ Ft. from N. Line

990 Ft. from S. Line990 Ft. from E. Line

_____ Ft. from W. Line

Location ✓

Rig up _____

Drilling and Remarks:

RECORD

Cased _____ in., _____ ft.

Sand _____

Gas _____

Oil _____

Total Depth _____

PRODUCTION

1st 24 hrs. Nat. _____

1st 24 hrs. after shot _____

Gas _____ Cu. Ft.

Dry Hole _____

Abandoned _____

Date

AUG 11 1937 19H. D. Hatfield Scout

key

Returned	
Cards	
Tracing	
France Map	
Sea borough Map	
Moody Map	
Sea borough Plot Book	
Moody Flat Book	

Ellis

KANSAS

Map No. _____ Sec. 28 Twp. 11 R. 17WWell No. 12 Bemis "A"Texas

Company _____

Contractor _____

COMPLETED

NW SE NE

SECTION PLAT

			0

_____ Ft. from N. Line

990 Ft. from S. Line990 Ft. from E. Line

_____ Ft. from W. Line

Location _____

Rig up _____

Drilling and Remarks:

1000 Acid4000 "Rot - 78715" = 30
~~10" = 110'~~
RECORDCased 7" in., 3516 1/2Sand 511 3516

Gas _____

Oil _____

Total Depth 3543

PRODUCTION

1st 24 hrs. Nat. _____

1st 24 hrs. after shot _____

Gas _____ Cu. Ft.

Dry Hole _____

Abandoned _____

Date

OCT 20 1937 19H. D. Hatfield Scout

RAH

Returned

Cards

Tracing

RAH

Back