
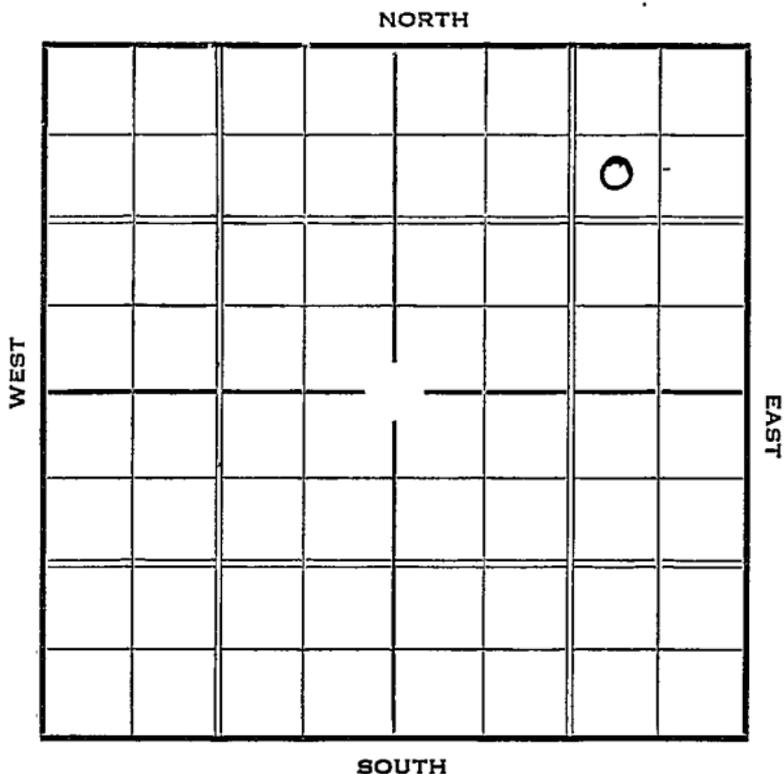


Section 28 Township 11 Range 17-W

Well Number #10 Bemis "A"

Company Texas

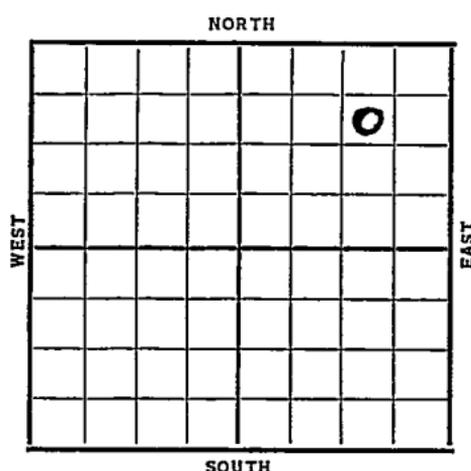

Sec. 28 Twp. 11 R. 17-WWell No. #10 Bemis "A" Farm  
Texas Company990 Ft. from N. Line       Ft. from S. Line990 Ft. from E. Line       Ft. from W. Line

Date	REPORT
1937	
7/21	B.R.R.
7/30	R. R.
8/6	Rig.
8/13	R. U. R.
8/20	Anhy 1200'. 10" @ 1210'. WOC.
8/28	Drlg. 2795'.
9/3	Simp. 3454'. Sil. 3472'. T.D. 3473'. SD for pipe.
9/10	7" @ 3473'. T.D. 3481'. Testing
9/15	7" @ 3473' Sil 3472' TD 3482' P - 348/4 & 403/4 Pot 2307
	COMPLETED

*Ellis*Map No. 71 Sec. 28 Twp. 11 R. 17<sup>w</sup>Well No. 10 - Bemis "A"Texas Company

Contractor

## FIRST REPORT

## SECTION PLAT

990 Ft. from N. Line

\_\_\_\_\_ Ft. from S. Line

990 Ft. from E. Line

\_\_\_\_\_ Ft. from W. Line

			0

Location \_\_\_\_\_

Rig up \_\_\_\_\_

Drilling and Remarks:

*B.R.R.*

## RECORD

Cased \_\_\_\_\_ in., \_\_\_\_\_ ft.

Sand \_\_\_\_\_

Gas \_\_\_\_\_

Oil \_\_\_\_\_

Total Depth \_\_\_\_\_

## PRODUCTION

1st 24 hrs. Nat. \_\_\_\_\_

1st 24 hrs. after shot: \_\_\_\_\_

Gas \_\_\_\_\_ Cu. Ft.

Dry Hole \_\_\_\_\_

Abandoned \_\_\_\_\_

Date

JUL 21 1937 19 H. D. Hatfield Scout

*Ellis* KANSAS

Map No. \_\_\_\_\_ Sec. 28 Twp. 11 R. 17<sup>w</sup>

Well No. 10-Bennis "A"

Texas Company

Contractor \_\_\_\_\_

**COMPLETED**

**SECTION PLAT**

990 Ft. from N. Line

\_\_\_\_\_ Ft. from S. Line

990 Ft. from E. Line

\_\_\_\_\_ Ft. from W. Line

			0

Location \_\_\_\_\_

Rig up \_\_\_\_\_

Drilling and Remarks:

*P-348/4 & 403/4*

*Pot-2307*

**RECORD**

Cased 7 in., 3473 ft.

Sand 5113472

Gas \_\_\_\_\_

Oil \_\_\_\_\_

Total Depth 3482

**PRODUCTION**

1st 24 hrs. Nat. \_\_\_\_\_

1st 24 hrs. after shot \_\_\_\_\_

Gas \_\_\_\_\_ Cu. Ft.

Dry Hole \_\_\_\_\_

Abandoned \_\_\_\_\_

Date

SEP 15 1937 19

H. D. Hatfield Scout