


Section.....28.....Township.....11.....Range.....17-W

Well Number #9 Bemis "A".....

Company.....Texas.....

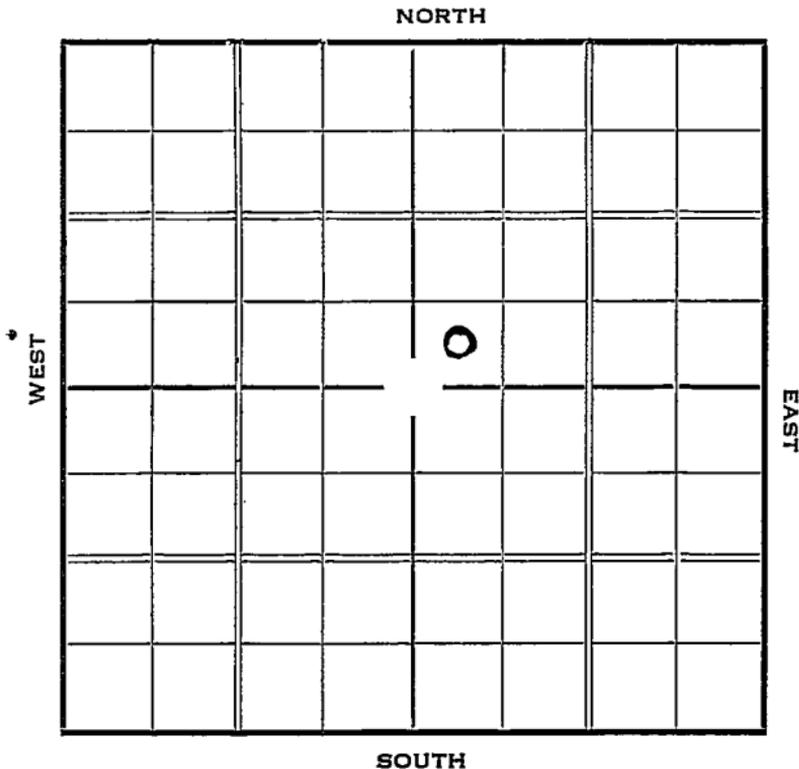

Sec. 28 Twp. 11 R. 17-W

Well No. #9 Bemis "A" Farm

Texas Company


         Ft. from N. Line

330 Ft. from S. Line

         Ft. from E. Line

330 Ft. from W. Line

Elev. 1906

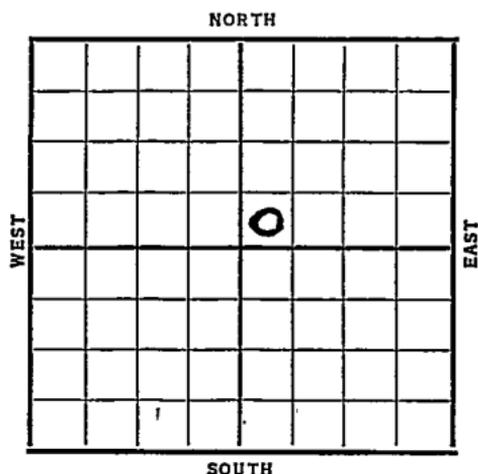

Date	REPORT
1937	
7/21	B.R.R.
7/30	10" @ 1125'. Anhy 1118'. WOG.
8/6	Dr1g. 2750'.
8/13	Sil. 3399'. 7" @ 3400'. T.D. 3402'. RUST.
8/20	" " "
8/28	" " "
9/1	7" @ 3400'.
	Sil. 3399'.
	T.D. 3410'.
	Pot. 2048 bbls.
	<b>COMPLETED</b>

*Ellis*Map No. 71 Sec. 28 Twp. 11 R. 17WWell No. 9-Bemis "A"Texas Company

Contractor

## FIRST REPORT

## SECTION PLAT

\_\_\_\_\_ Ft. from N. Line

330 Ft. from S. Line

\_\_\_\_\_ Ft. from E. Line

330 Ft. from W. Line

		0	

Location \_\_\_\_\_

Rig up \_\_\_\_\_

Drilling and Remarks:

*BRR*

## RECORD

Cased \_\_\_\_\_ in., \_\_\_\_\_ ft.

Sand \_\_\_\_\_

Gas \_\_\_\_\_

Oil \_\_\_\_\_

Total Depth \_\_\_\_\_

## PRODUCTION

1st 24 hrs. Nat. \_\_\_\_\_

1st 24 hrs. after shot \_\_\_\_\_

Gas \_\_\_\_\_ Cu. Ft.

Dry Hole \_\_\_\_\_

Abandoned \_\_\_\_\_

Date

JUL 21 1937

H. D. Hatfield Scout

Ellis KANSAS

Map No. \_\_\_\_\_ Sec. 28 Twp. 11 R. 17WWell No. 9-Bennis "A"Texas Company

Contractor \_\_\_\_\_

COMPLETED

## SECTION PLAT

		0	

\_\_\_\_\_ Ft. from N. Line

330 Ft. from S. Line

\_\_\_\_\_ Ft. from E. Line

330 Ft. from W. Line

Location \_\_\_\_\_

Rig up \_\_\_\_\_

Drilling and Remarks:

## RECORD

Cased 7 in., 3400 ft.Sand S11 3399

Gas \_\_\_\_\_

Oil \_\_\_\_\_

Total Depth 3410

## PRODUCTION

1st 24 hrs. Nat. \_\_\_\_\_

1st 24 hrs. after shot \_\_\_\_\_

Gas \_\_\_\_\_ Cu. Ft.

Dry Hole \_\_\_\_\_

Abandoned \_\_\_\_\_

Date

SEP 1 1937 19

H. D. Hatfield Scout