


Section 28 Township 11 Range 17-W

Well Number #7 Bemis "A"

Company Texas

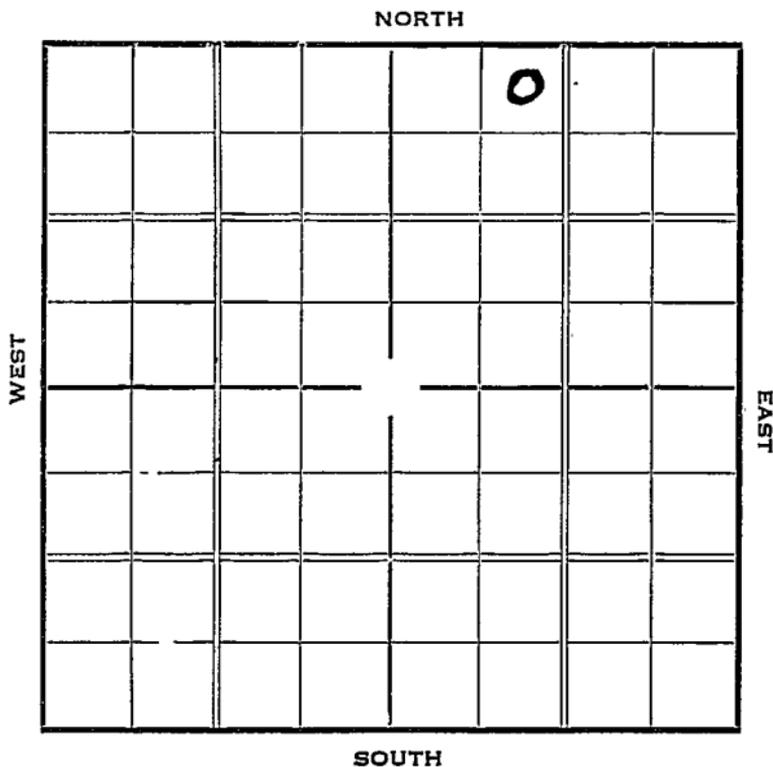

Sec. 28 Twp. 11 R. 17-W

Well No. #7 Bemis "A" Farm

Texas Company


330 Ft. from N. Line

 Ft. from S. Line

 Ft. from E. Line

990 Ft. from W. Line

Elev. 1888

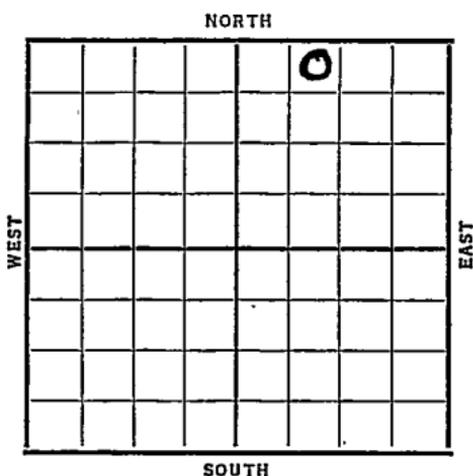

Date	REPORT
1937	
6/30	Rig
7/9	15" @ 32' Drlg. 835'.
7/16	Anhy 1094'. 10" @ 1100'.
	Drlg. 2130'.
7/23	Drlg. 3201'.
7/30	Sil. 3380'. 6" @ 3381'.
	T.D. 3382'. RUST.
8/6	" " "
8/13	T.D. 3390'. 3200' oil 24 hrs.
8/18	6" @ 3381'.
	Sil. 3380'.
	T.D. 3390'.
	Pot. 2034 bbls.
	COMPLETED

Ellis KANSAS

Map No. _____ Sec. 28 Twp. 11 R. 17^w

Well No. 7-Bernis "A"

Texas Company

Contractor _____

FIRST REPORT SECTION PLAT

330 Ft. from N. Line

_____ Ft. from S. Line

_____ Ft. from E. Line

990 Ft. from W. Line

		0	

Location _____

Rig up _____

Drilling and Remarks:

Rig

RECORD

Cased _____ in., _____ ft.

Sand _____

Gas _____

Oil _____

Total Depth _____

PRODUCTION

1st 24 hrs. Nat. _____

1st 24 hrs. after shot _____

Gas _____ Cu. Ft.

Dry Hole _____

Abandoned _____

Date

JUN 30 1937

19

H. D. Hatfield Scout

Ellis KANSAS

Map No. _____ Sec. 28 Twp. 11 R. 17^WWell No. 17 - Bemis "A"Texas Company

Contractor

COMPLETED

SECTION PLAT

330 Ft. from N. Line

_____ Ft. from S. Line

_____ Ft. from E. Line

990 Ft. from W. Line

		0	

Location _____

Rig up _____

Drilling and Remarks:

RECORD

Cased 6 in., 3381 ft.Sand 511 3380

Gas _____

Oil _____

Total Depth 3390

PRODUCTION

1st 24 hrs. Nat. _____

1st 24 hrs. after shot _____

Gas _____ Cu. Ft.

Dry Hole _____

Abandoned _____

Pat - 2034

Date

AUG 18 1937₁₉

H. D. Hatfield Scout