


Section 28 Township 11 Range 17-W


Well Number 3 Bemis "A"

Company Texas

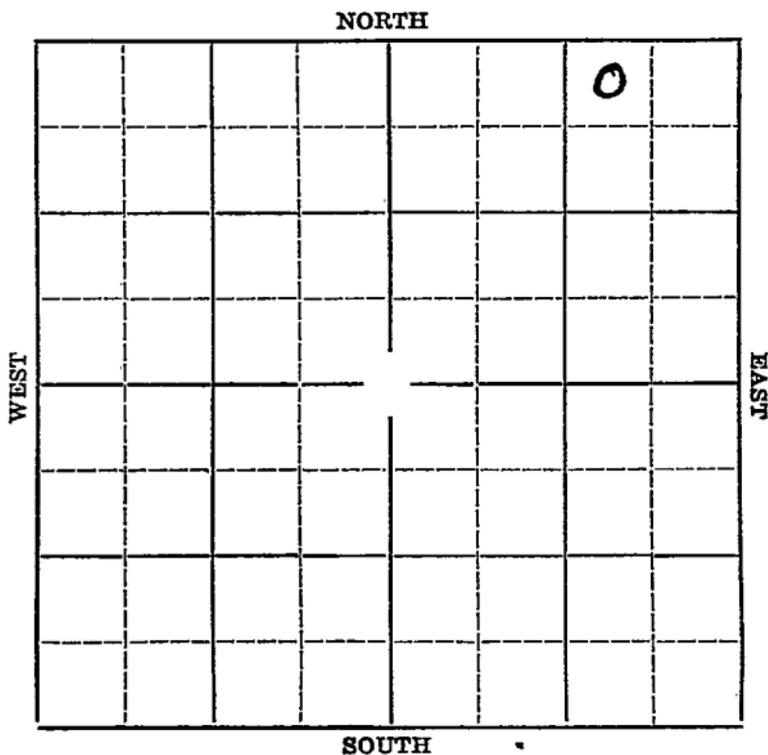

Sec. 28 Twp. 11 R. 17-WWell No. #3 Bemis "A" Farm
Texas Company330 Ft. from N. Line Ft. from S. Line990 Ft. from E. Line Ft. from W. Line

Elev. 1882

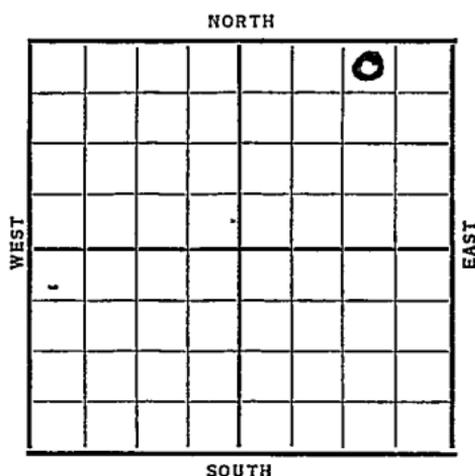

Date	REPORT
1937	
4/21	Location
4/30	Rotary rig.
5/7	15" @ 60'. WOC.
5/14	Anhy 1088'. 10" @ 1093'.
	WOC.
5/21	Drlg. 2200'.
5/28	Drlg. 3085'.
6/4	Simp. 3357'. Sil. 3364'.
	7" @ 3365'. T.D. 3366'.
	RUST.
6/11	T.D. 3380'. 3000' oil in 3 hrs. On Pot.
	OVER

1937

6/16 7" @ 3365'.

Sil. 3364'.

T.D. 3382'.

Pot. 2095 bbls. 24 hrs Nat.

COMPLETED

KANSAS *Ellis*

Map No. _____ Sec. 28 Twp. 11 R. 17W

Well No. 3 Benis "A"

Texas Company

Contractor _____

SECTION PLAT

830 Ft. from N. Line

_____ Ft. from S. Line

990 Ft. from E. Line

_____ Ft. from W. Line

			0

FIRST REPORT

Location ✓

Rig up _____

Drilling and Remarks:

RECORD

Cased _____ in., _____ ft.

Sand _____

Gas _____

Oil _____

Total Depth _____

PRODUCTION

1st 24 hrs. Nat. _____

1st 24 hrs. after shot _____

Gas _____ Cu. Ft.

Dry Hole _____

Abandoned _____


Date

APR 21 1937 19

S. J. LEWIS Scout

[Handwritten mark]

[Handwritten signature]

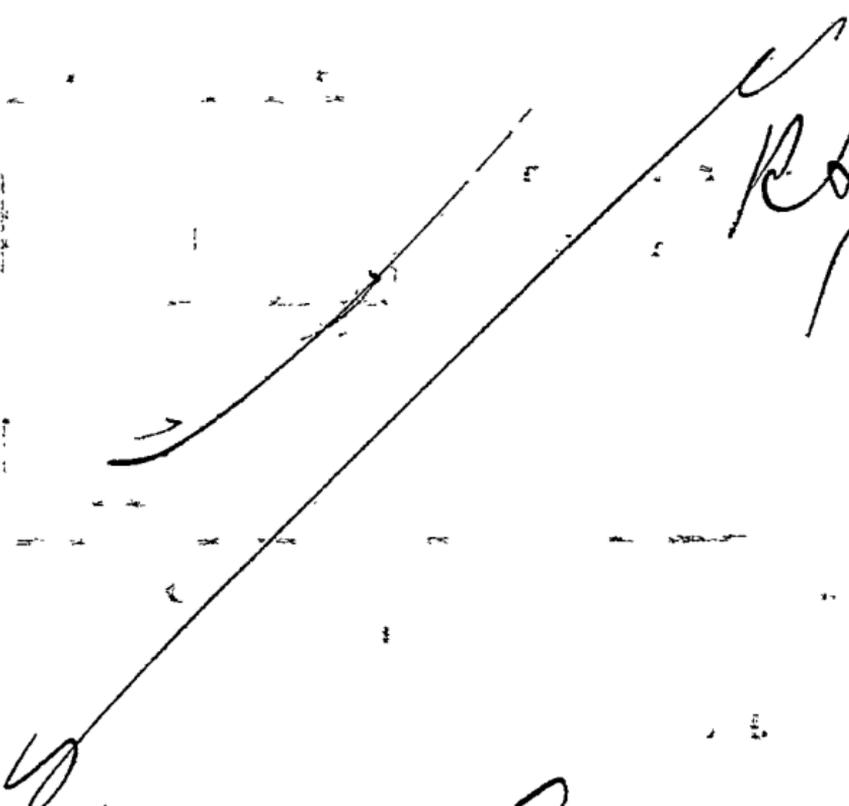

Returned	
Cards	<i>[Handwritten signature]</i>
Tracing	<i>[Handwritten signature]</i>
France Map	<i>[Handwritten signature]</i>
Scarborough Map	<i>[Handwritten signature]</i>
Moody Map	<i>[Handwritten signature]</i>
Scarborough Plat Book	
Moody Plat Book	

Ellis KANSAS

Map No. 71 Sec. 28 Twp. 11 R. 17^w

Well No. 3 - Bernis "A"

Texas Company

Contractor

COMPLETED

SECTION PLAT

330 Ft. from N. Line

1 Ft. from S. Line

990 Ft. from E. Line

_____ Ft. from W. Line

			0

Location _____

Rig up _____

Drilling and Remarks:

Pat - 2095 / 24
NET

RECORD

Cased 7 in., 3365 ft.

Sand sil 3364

Gas _____

Oil _____

Total Depth 3382

PRODUCTION

1st 24 hrs. Nat. _____

1st 24 hrs. after shot _____

Gas _____ Cu. Ft.

Dry Hole _____

Abandoned 62

Date

JUN 16 1937 19 H. D. Hatfield Scout

[Handwritten scribbles and lines]

[Handwritten initials]

Returned	
Cards	<i>[Handwritten initials]</i>
Tracing	<i>[Handwritten initials]</i>
France Map	<i>[Handwritten initials]</i>
Scarborough Map	<i>[Handwritten initials]</i>
Moody Map	<i>[Handwritten initials]</i>
Scarborough Plat Book	
Moody Plat Book	