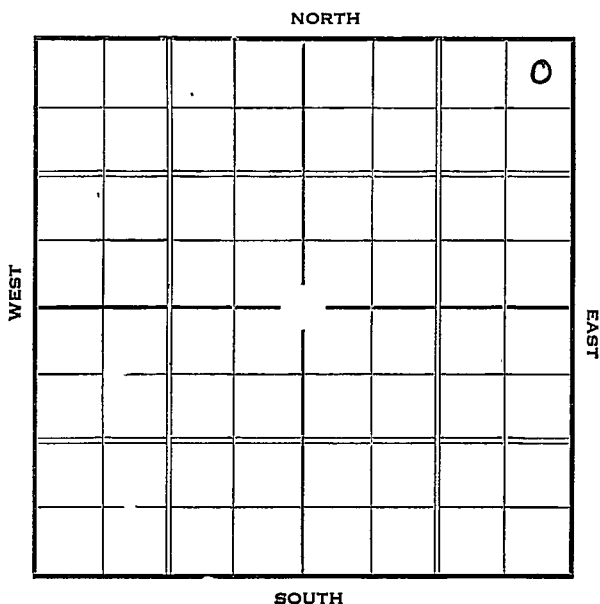


KANSAS Ellis

Section 28 Township 11 Range 17-WWell Number 1 Bemis "A"Company Texas

Map No. _____ Sec. 28 Twp. 11 R. 12WWell No. 1 Bemis "A"Texas Company

Contractor _____

SECTION PLAT

			0

330 Ft. from N. Line

_____ Ft. from S. Line

330 Ft. from E. Line

_____ Ft. from W. Line

FIRST REPORT

Location _____

Rig up _____

Drilling and Remarks:

ROG

RECORD

Cased _____ in., _____ ft.

Sand _____

Gas _____

Oil _____

Total Depth _____

PRODUCTION

1st 24 hrs. Nat. _____

1st 24 hrs. after shot _____

Gas _____ Cu., Ft.

Dry Hole _____

Abandoned _____

Date

FEB 10 1937

19

S. J. LEWIS Scout

Ellis KANSAS

Map No. 71 Sec. 28 Twp. 11 R. 17 ^WWell No. 1 - Bemis "A"Texas Company

Contractor

COMPLETED
COMPLETED330 Ft. from N. Line Ft. from S. Line330 Ft. from E. Line Ft. from W. Line

SECTION PLAT

			0

Location Rig up

Drilling and Remarks:

Lot 2662

RECORD

Cased in., ft.Sand T. Sil - 3442Gas Oil Total Depth 3458

PRODUCTION

1st 24 hrs. Nat. 1st 24 hrs. after shot Gas Cu. Ft.Dry Hole Abandoned

Date

APR 28 1937

19

H. D. Hatfield Scout