


Section 28 Township 11 Range 21 W

Well No. #1 Lynd "B"

Company Petroleum Inc.

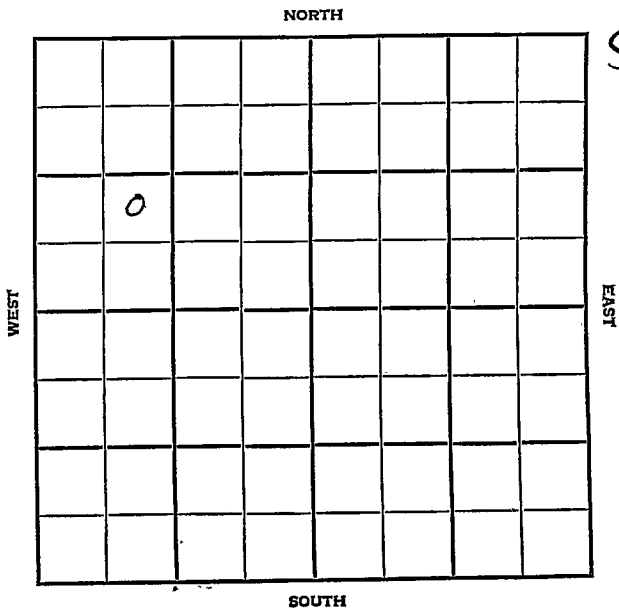

SEC.	28	TWP.	11	R.	21W
------	----	------	----	----	-----

WELL NO. #1 Lynd "B" FARM

COMPANY Petroleum Inc.


CONTRACTOR Garvey
Wildcat

_____ Ft. from N. Line

_____ Ft. from S. Line

_____ Ft. from E. Line

_____ Ft. from W. Line

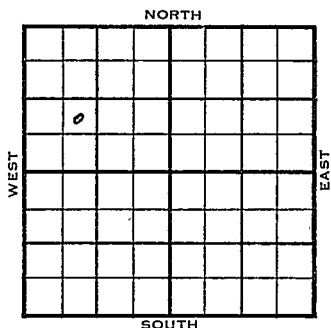

NE SW NW

1955	ELEVATION	REPORT
	2235 DF	
8/31	Comm 8-27-55 8" @ 220/150 Drlg 2260	
9-14	DST 3541-3634 op 1 hr. rec. 335' mw, BHP 1300# 20"; DST 3666-3770, op 1 hr. rec. 40' mud, BHP 240#; DST 3764-3880 op 1 hr. rec 35' mud, BHP 380#; DST 3910-20 op 45" rec. 20' mud, BHP Off 380 DST 3921-35 op 45 min. rec. 10' mud BHP Off 20"; D & A Tops: H. 3511 Tr. 3533 L. 3547 Marm cht. 3849 A 3908 T.D. 3955'	

ABANDONED

County Wago Elev. _____
 Sec. 28 Twp. 37 Rge. 21W
 Company Petroleum Inc.
 Farm Name Lynd #B No. 1

TOPS	DEPTH	LOG	DATUM	Loc. in Sec.
Anh.				NE SW NW
Tp.				
H.				
Tr.				
Dg.				
Bl.				
L.				Geol. _____
K.C.				Contr. _____
B.K.C.				
Ce.				<u>Garvey</u>
C.				
M.				Pool _____
M.				<u>Wildcat</u>
K.				
Mz.				
Mq.				
V.				
S.				
S.				
A.				
R.				
PE.				
G.				
T.D.				

Date Comm. 8-27-55
8" @ 220/350 drlg. 2260

[Handwritten signature]

Co. Lse. No. Sec. T. R.

County Trego Elev. 2235 DF

Sec. 28 Twp. 17 Rge. 21W

Company Petroleum, Inc.

FarmName Lynd "B" No. 1

TOPS	DEPTH	LOG	DATUM
Anh.			
TP.			
H.	3511		1276
Tr.	3533		1298
Dg.			
BL.			
Warm cmt	3517		1312
	3049		1011
B.K.C.			
Ce.			
C.			
M.			
M.			
K.			
Mz.			
Ma.			
V.			
S.			
S.			
A.	3908		1673
R.			
Pe.			
G.			
TR.	3955		

Loc. in Sec. NE SW NW

Geol. _____
 Contr. Garvey

Pool W.C.

ABANDONED

Date Comm. 8-27-55 SEP 14 1955

8" 220 w/150; DST 3541-3634 op 1 hr. rec.
 335' mw, BHP 1300# 20"; DST 3666-3770
 op 1 hr. rec. 40' mud, BHP 240#; DST 3764-
 3880 op. 1 hr. rec. 35' mud, BHP 380#;
 DST 3910-20 op 45" rec. 20' mud, BHP 0#;
 DST 3921-35 op 45 min. rec. 10' mud, BHP 0#
 20";

D & A