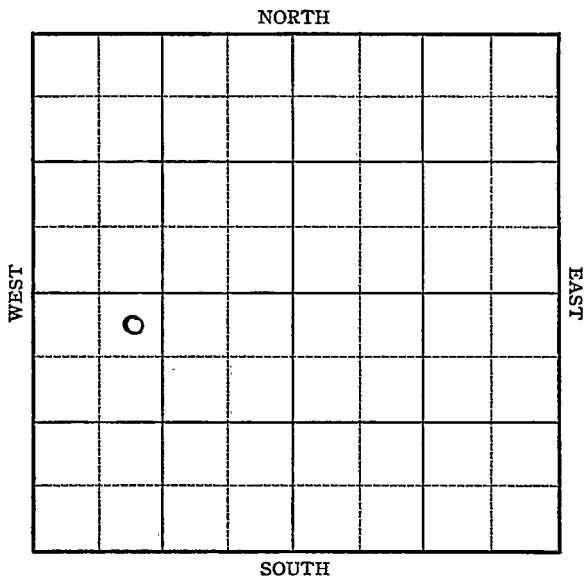


Section 28 Township 11 Range 17-WWell No. 3 BemisCompany York State Oil


KANSAS

Ellis

Sec. 28 Twp. 11 R. 17Well No. #3 Bemis FarmYork State Oil Company330 Ft. from N. Line

Ft. from S. Line

Ft. from E. Line

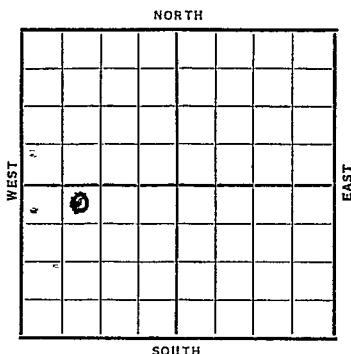990 Ft. from W. Line

Date	REPORT
1937	
12/22	Location
12/31	"
1938	"
1/7	"
1/14	"
1/20	"
1/28	R.O.G.
2/4	R.U.R.
2/9	15" @ 134'. Drlg. 900'.
2/18	10" @ 1172'. Anhy 1200'?
	Drlg. 1400'.
2/26	Drlg. 2780'.
3/4	Drlg. 3318'.
3/11	Arb. 3437 & 7". T.D. 3438'.
	RUST.
3/18	T.D. 3459'. 100' oil in 24 hrs.
	1000 a cid.
	OVER

1938

3/23

7" @ 3437'.

Arb. 3437'.

T.D. 3459'.

1000 acid.

Potential 1181 bbls.

COMPLETED

Ellis

KANSAS

Map No. 71 Sec. 28 Twp. 11 R. 17WWell No. 3 Bemis

York State Oil

Company

Contractor

COMPLETED

NE NW SW

330 Ft. from N. Line Ft. from S. Line Ft. from E. Line990 Ft. from W. Line

SECTION PLAT

0			

Location Rig up

Drilling and Remarks:

*1000 acid**PT 1181*

RECORD

Cased 7 in., 3437 ft.Sand Arb 3437Gas Oil Total Depth 3459

PRODUCTION

1st 24 hrs. Nat. 1st 24 hrs. after shot Gas Cu. Ft.Dry Hole Abandoned

Date

MAR 23 1938 19

H. D. Hatfield

Scout

Ray

Returned _____
Cards _____
Tracing _____
France Map _____
Scarborough Map _____
Moody Map _____
Scarborough Plat Book _____
Moody Plat Book _____

Map No. 71 Sec. 28 Twp. 11 R. 17WWell No. 3 BemisYork State Oil

Company

Contractor

FIRST REPORT

NE NW SW

SECTION PLAT

0			

330 Ft. from N. Line Ft. from S. Line Ft. from E. Line990 Ft. from W. LineLocation XRig up

Drilling and Remarks:

RECORD

Cased in., ft.Sand Gas Oil Total Depth

PRODUCTION

1st 24 hrs. Nat. 1st 24 hrs. after shot Gas Cu. Ft.Dry Hole Abandoned

Date

DEC 22 1937

19

H. D. Hatfield


Scout





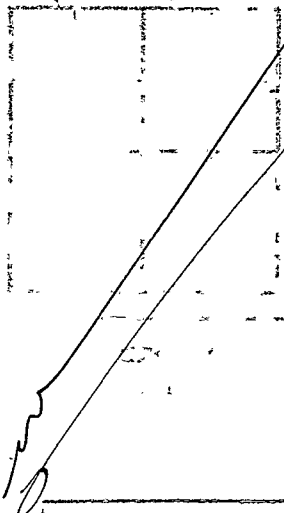


