


Ellis

KANSAS

Section.....28.....Township.....11.....Range.....17-W

Well Number.....2 - Bemis.....

Company.....Wentz.....

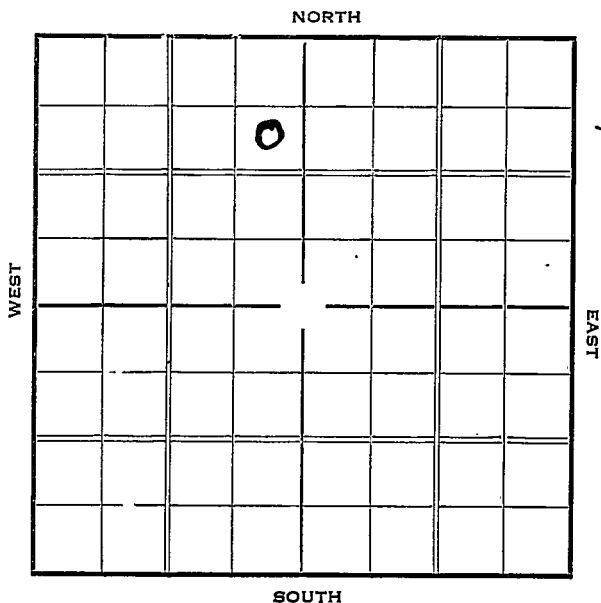

OK


Form 252-A-5M-7-36-Palace

KANSAS

Ellis

Sec. 28 Twp. 11 R. 17-WWell No. #2 Bemis FarmWentz Company990 Ft. from N. Line Ft. from S. Line330 Ft. from E. Line Ft. from W. Line

Elev. 1953

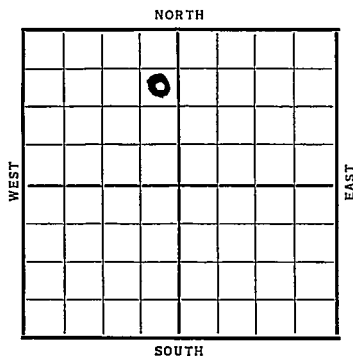

Date	REPORT
1937	
6/23	R U R
7/2	Anhy 1178'. T.D. 1196'.
	Reaming.
7/9	10" @ 1196'. Drlg. 2145'.
7/16	Drlg. 3195'.
7/23	Simp. 3455-59'.
	7" @ 3459'. Sil. 3461'.
	T.D. 3464'. RUST.
7/28	7" @ 3459'.
	Sil. 3461'.
	T.D. 3466'.
	Pump 816 bbls. 6 hrs.
	Pot. 2588 bbls.
	Nat.
	COMPLETED

Ellis **KANSAS**
 Map No. 71 Sec. 28 Twp. 11 R. 17^W
 Well No. 2 - Bemis
Wentz Company
 Contractor

FIRST REPORT**SECTION PLAT**

	0		

990 Ft. from N. Line

_____ Ft. from S. Line

330 Ft. from E. Line

_____ Ft. from W. Line

Location _____

Rig up _____

Drilling and Remarks:

R. U. R.**RECORD**

Cased _____ in., _____ ft.

Sand _____

Gas _____

Oil _____

Total Depth _____

PRODUCTION

1st 24 hrs. Nat. _____

1st 24 hrs. after shot _____

Gas _____ Cu. Ft.

Dry Hole _____

Abandoned _____

Date

JUN 23 1937

19

H. D. Hatfield

Scout

Map No. _____ Sec. 28 Twp. 11 R. 17^WWell No. 2 - BemisWentz Company

Contractor

COMPLETED

990 Ft. from N. Line

_____ Ft. from S. Line

330 Ft. from E. Line

_____ Ft. from W. Line

SECTION PLAT

	0		

Location _____

Rig up _____

Drilling and Remarks:

Pump 7 1/6

Pot - 2588

nat.

RECORD

Cased 7 in., 3459 ft.Sand 511 3461

Gas _____

Oil _____

Total Depth 3466

PRODUCTION

1st 24 hrs. Nat. _____

1st 24 hrs. after shot _____

Gas _____ Cu. Ft.

Dry Hole _____

Abandoned _____

Date

JUL 28 1937

19

H. D. Hatfield

Scout