


Trego

KANCAS

SECTION 28 TOWNSHIP 11S RANGE 24W

WELL NO. #2 Martin

COMPANY J-S-F

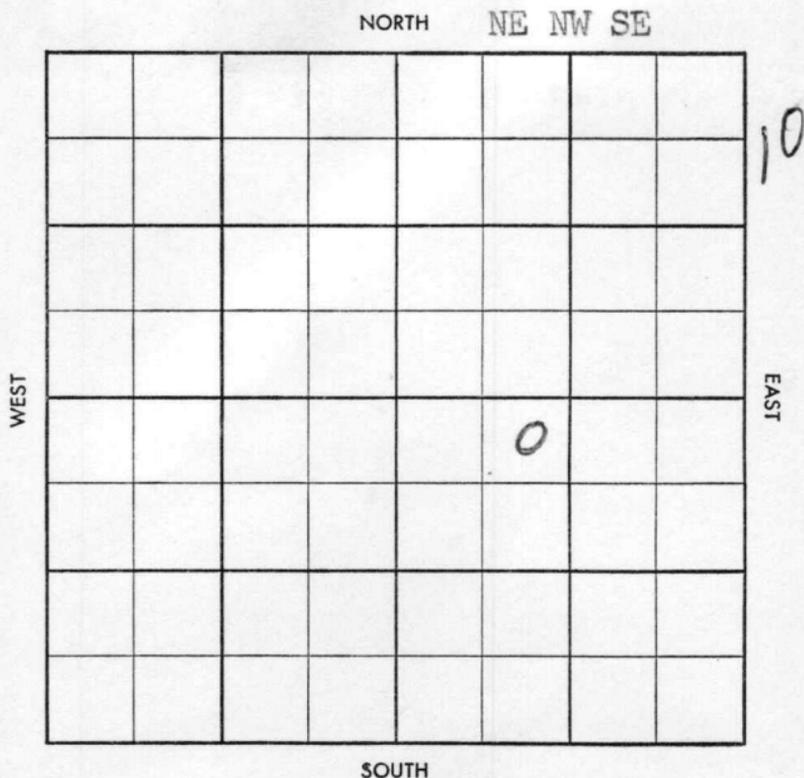

Twp. X Pool X
 Co. X Facet X

S-513-A

CO. Trego ELEV. 3476
 SEC. 28 TWP. 11 RGE. 24W
 COMPANY J-S-F NO. 2

COMPLETE
 APR 30 '58

FARM Martin
 LOC. NE NW SE

Anh. 2059
L 3836 - 1358
TD 4070

GEOL. _____
 CONTR. Co. tools
 POOL Voda
 SPUD 11-26-57
8" @ 198/135
drlg. 3285 DEC 11 '57
Hb 3798 TR 3821
Lsg 3836 DST
3910 - 25 60"
585' MSW IP

0-240 BHP 1320 DST
3999-4003 60" 90' OCM
BHP 1400/120" DST 4003-22
60" 120' OCM BHP 260/120"
Y ahead TD 4070
5 1/2 4069/125 CO 48/4012-24
B 1090 + 59w 30min (3) \$16B0
ph + 590 w NT Test
DEC 26 '57 SQ PB 5D 4012-24 JAN 2 '58
PB4010 32 3995-4003

A 19 Fph 1500A \$4.16
B FPH 30% Aw tstg
JAN 8 '58 PDP JAN 15 '58 JAN 22 '58 P
30 BOPD + 2390w wspot
JAN 29 '58 FEB 5 '58 P 14 BOPD
+ 1390 W. FEB 12 '58 FEB 19 '58
FEB 26 '58 P 16 B F PD 5% w
MAR 5 '58 MAR 12 '58 MAR 19 '58 MAR 26 '58 APR 2 '58
~~P 14 BOPD~~ APR 9 '58 APR 16 '58 APR 23 '58
APR 30 '58 Phyp 30 BOPD +
23% w Lsg 3995-4003
9w 36°

CO
LSE
NO
SEC
TWP
RGE