


Ellis

KANSAS

SECTION 29 TOWNSHIP 11 RANGE 16W

WELL NO. #1 Potter "C"

COMPANY Franco Central

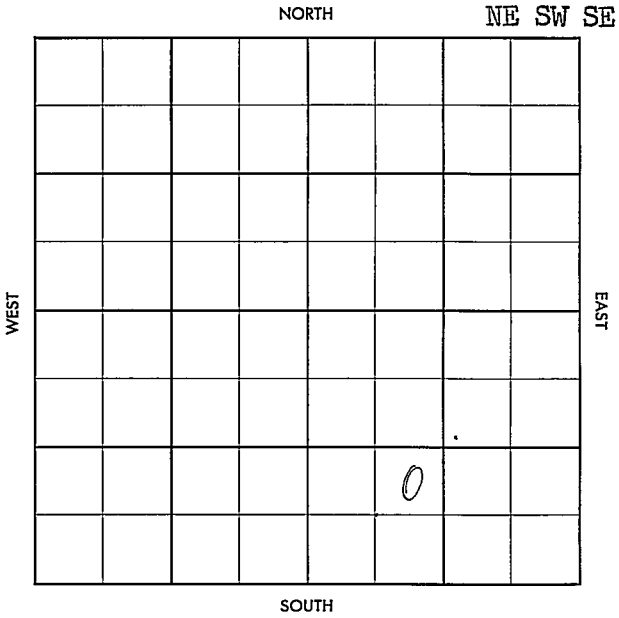

WILDCAT

FORM 513 SUNRAY

County	ELIAs	Elev.	
Sec.	29	Twp.	11
		Rge.	16W
Company	Franco Central		
Farm Name	Potter "C"	No.	1

TOPS	DEPTH	LOG	DATUM	Loc. in Sec.
Anh.				NE SW SE
Tr.				
H.				
Tr.				
Dg.				
Bl.				
L.				Geol.
K.C.				Contr.
B.K.C.				Lewis Drlg.
Ce.				
C.				Pool
M.				Wildcat
K.				
Mz.				
Ma.				
V.				
S.				FIRST REPORT
A.				
R.				
Pe.				
G.				
T.D.				

Date Comm. M I R T

	No.
	Sec.
	T.
	R.

(Handwritten signature)

(Handwritten signature)

County Lilis *Elev. 1812 DF
 Sec. 29 Twp. 11 Rge. 16W
 Company Aranco Central
 Farm Name Potter "C" No. 1

TOPS	DEPTH	LOG	DATUM
Anh.			
Tr.			
H.	<u>2980</u>		
Tr.			
Dg.			
Bl.			
L.	<u>3029</u>		
K.C.			
B.K.C.	<u>3267</u>		
Ce.			
C.	<u>3328</u>		
M.			
M.			
K.	<u>3382</u>		
Mz.			
Mo.			
V.			
S.			
S.			
A.	<u>3382</u>		
R.			
PE.			
G.			
TD.	<u>3410</u>		

Loc. in Sec. NE SW SE
 Geol. _____
 Contr. Lewis Driv.
 Pool Wildcat
ABANDONED
 JUN 12 57
 O

Date Comm.

WIRT. - 5? 5-28-57 85/8 @
1010/450 @ 2615 JUN 12 '57 X 146 2980
L-KC 3029 DST 3047-3100 gr
1hr 300' Gas rec. 30' HOCM +
230' oily Mdy w/ht. BHP 880/30"
BKC 3267 c9 3328 A/B 3382
RTD 3410 Log.
DEA
See to #1 11/57