

Ellis


DX 78-1

KANSAS

Section 29 Township 11 Range 16W

Well No. #1 Potter "F"

Company Heathman-Seeligson

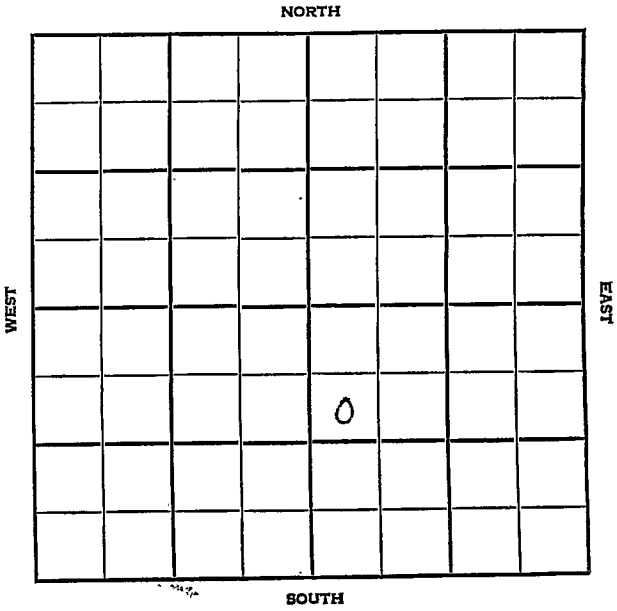

Ellis

KANSAS

SEC.

29

TWP.

11

R.

16W

WELL NO.

#1 Potter "F"

FARM

COMPANY

Heathman-Seeligson

CONTRACTOR

Co. Tools.

Bemis-Shutts Pool^{NORTH}

990


Ft. from N. Line

Ft. from S. Line

Ft. from E. Line

330

Ft. from W. Line

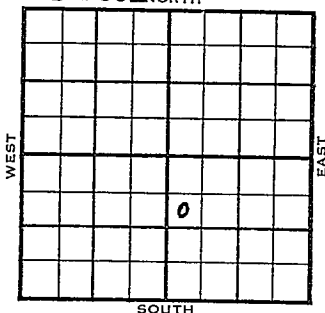

SW NW SE

	ELEVATION	REPORT
1955	1832'	
4/13 4/27	Location Spud 4-13-55 D & A TD 3396' 10" @ 160' Anhy 1005', Top 2760' DST 2945'-80' opn 1 hr, rec 690' wtr, 1185# Heeb. 3000' Lans 3047' DST 3126'-42' opn 1 hr, rec 460' s.w. 960# B KC 3266' Cong. 3344' Arb. 3388' TD 3396' D & A	<p style="text-align: center; font-weight: bold; font-size: 1.2em;">ABANDONED</p>

County Ellis State Kansas

Sec. 29 (Blk. 11) (Sur. 16W) (Twp. 11) Map No.

Operator Heathman-Seeligson

Well No. 1 Farm Potter "F"

Elev. 1832 Location SW NW SE

990 Ft. From N Line SE

330 Ft. From W Line Quarter

1st. Report

Completion APR 27 1955

Remarks Bemis-Shutts Pool

Co. tools

Spudding Date 4-13-55

Drlg. Data D & A TD 3396

10" @ 160 Anhy 1005 Top. 2760

DST 2945-80 open 1 hr. Rec. 690'wtr.

1185# Heeb. 3000 Lans. 3047 DST 3126-

42 open 1 hr. Rec. 460' sw 960#

B KC 3266 Cong. 3344 Arb. 3388

TD 3396

D & A

FABEN GILSTRAP