

Ellis

KANSAS

29


11S

16W

SECTION _____ TOWNSHIP _____ RANGE _____

WELL NO. #9 Potter

COMPANY Franco Central

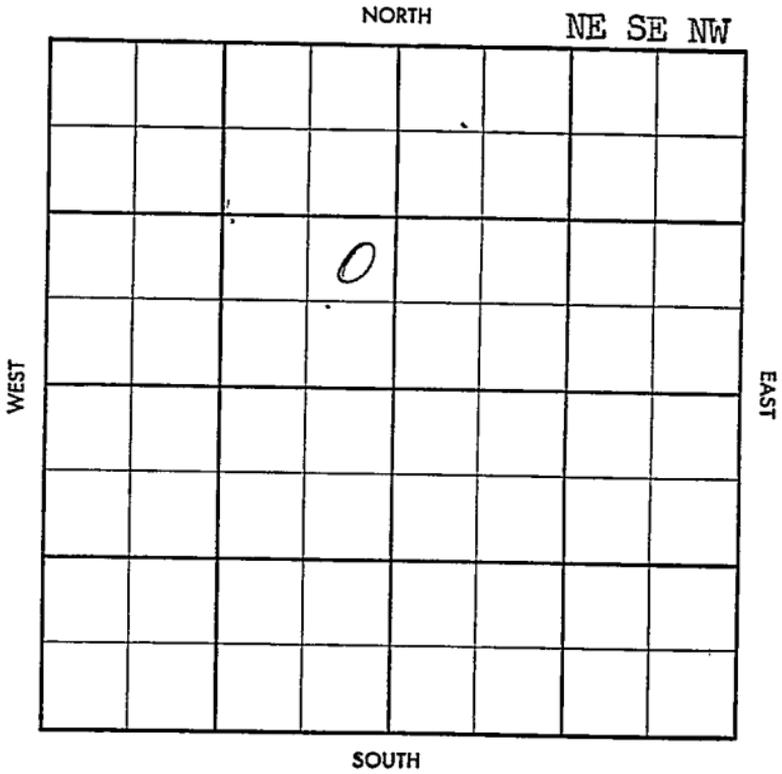

S-513-A

CO. Ellis ELEV. 808

SEC. 29 TWP. 11 RGE. 16W

COMPANY Franco Central NO. 9

DEC 4 '57
COMPLETE

FARM Potter

LOC. NE SE NW

GEOL. _____

CONTR. Lewis Drlg.

POOL Potter

SPUD 9-26-57

Location ft

828999/

D 2620 "1" 57

log top H 2968

TR 2992 L 3017

BKC 3278 S 3298

A 3315 TD 3395 5 1/2"

3393 w oct 23 10 24/3374-80

\$ 2B wph 550 PB 3368

96/3316-40 FU 1500' 01' NW

1ln \$ 11B wph 30 min 1100' OB

PPP 23 57 0" 7"

NOV 20 57 DEC 4 57 PHL 234 BOPD

3109

arb 3316-40

CO.
LSE.
NO.
SEC.
TWP.
RGE.