


Ellis

KANSAS

SECTION 29 TOWNSHIP 11S RANGE 16W

WELL NO. #11 Potter

COMPANY Franco-Central

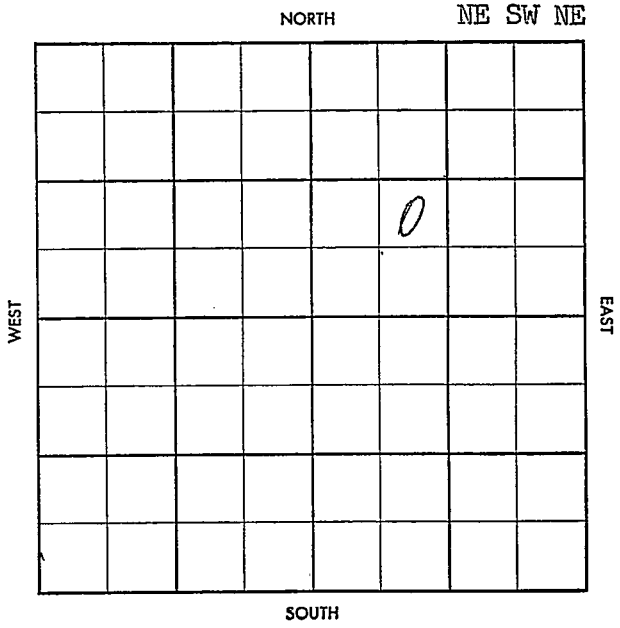

CO. ~~ELLS~~ ELEV. 1750

SEC. 29 TWP. 11 RGE. 10

COMPANY Franco-Canada No. ABANDONED

NOV 6 57

FARM 10th St

LOC. 10th St

- A 962
- Hb 2965
- TR 2990
- LKC 3015
- Bkc 3258
- 3324
- S 3333
- A 3346
- TD 3380

GEOL. _____

CONTR. _____

POOL _____

SPUD 10-2-57

Wellar & pits

MIRT

974/450

3165

no log notes

D & A

CO.

USE

NO.

SEC.

TWP.

RGE.