


Ellis

SECTION 29 TOWNSHIP 11 S RANGE 16 W

WELL NO. # 6 Potter

COMPANY Franco-Central

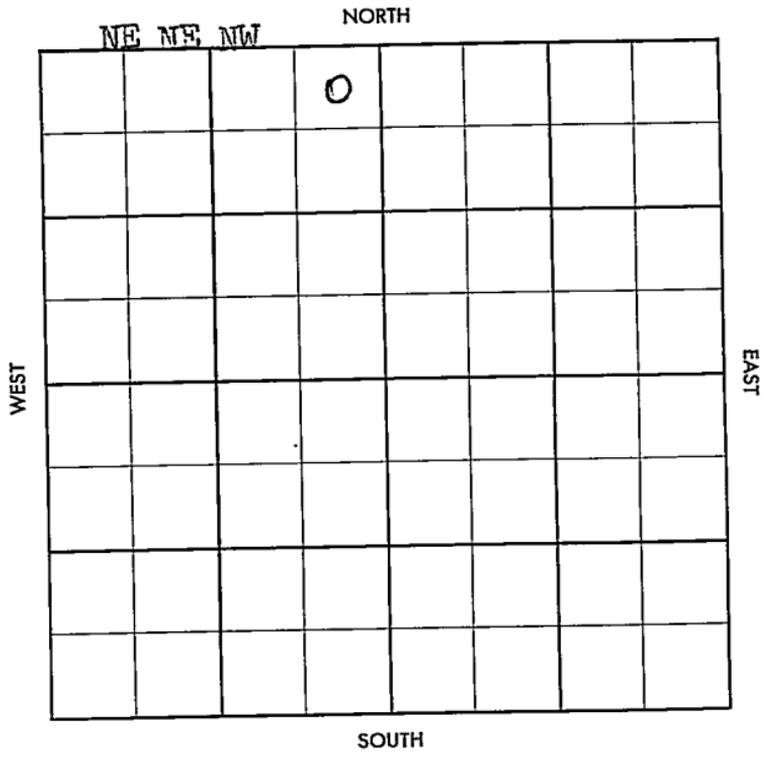

County Elk Elev. 1763 DF
 Sec. 29 Twp. 11 Rge. 16W
 Company Franco-Central
 Farm Name Potter No. 6

Co.
Sec.
No.
Sec.
T.
R.

TOPS	DEPTH	LOG	DATUM
Anh.	920		
Tp.			
H.			
Tr.			
Dg.			
Bl.			
L.			
K.C.			
B.K.C.			
Ce.			
C.			
M.			
M.			
K.			
Mz.			
Me.			
V.			
S.			
S.			
A.			
R.			
Pe.			
G.			
T.D.			

Loc. in Sec. _____
NE NE NW
 Geol. _____
 Contr _____
Lewis Drlg.
Tools
Pool
Potter

	0	
FIRST REPORT		
AUG 28 '57		

Date Comm. 8/21/57
8" @ 940 w/450 Drlg 2698

County Ellis Elev. 1763 DF
 Sec. 29 Twp. 11 Rge. 16W
 Company Franco-Central
 FarmName Potter No. 6

TOPS	DEPTH	LOG	DATUM
Anh.	920		
Ip.		2682	
H.		2921	
Tr.		2944	
Dg.			
Bl.			
L.		2972	
M.C.			
B.K.C.		3233	
Ce.			
C.			
M.			
M.			
K.			
Mz.			
Mo.			
V.			
S.		3260	
S. <u>54.</u>		3270	
A.		3276	
R.			
PE.			
G.			
T.D.	3346		

Loc. in Sec. NE NE NW
 Geol. _____
 Contr. Lewis Drlg.
Tools
Pool
Potter

OCT 23 57
COMPLETE

Date Comm. 8/21/57

8" @ 940 w/450 Drlg 2698 SEP 4 '57 5 1/2

334# SEP 11 '57 ~~3344~~ 60/3280-95

5 4.3 BOPH mW for this

to ~~...~~ SEP 18 '57 SEP 25 '57 OCT 2 '57

OCT 9 '57 OCT 15 '57 OCT 20 '57 PNY 152

B0 NW gr 320

Co
 Sec
 No.
 Sec.
 T.
 R.