


Ellis

KANSAS

SECTION 29 TOWNSHIP 11S RANGE 16W

WELL NO. #7 Potter

COMPANY Franco Central Oil

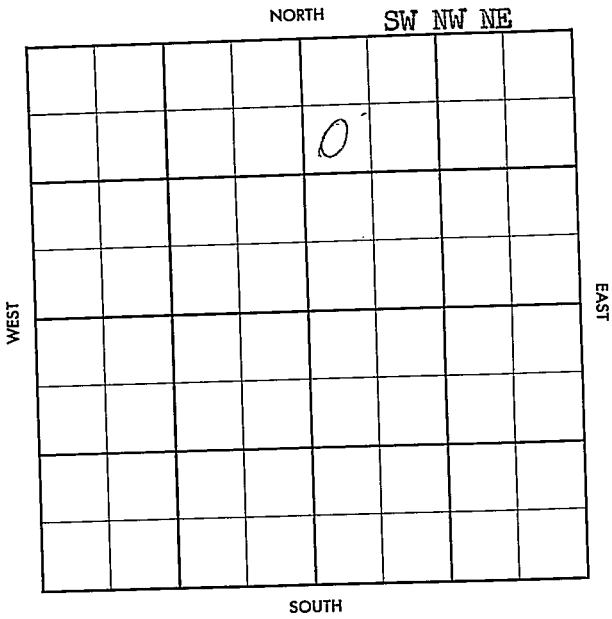

County Ellis Elev. 1764 DF
 Sec. 29 Twp. 77S Rge. 16W
 Company Franco Central Oil
 Farm Name Potter No. 7

TOPS	DEPTH	LOG	DATUM	Loc. in Sec.
Anh.	933			SW NW NE
TP.				
H.	2922			
Tr.	2945			
Dg.				
BL.				
L. <u>K.C.</u>	2972			Geol.
K.C.				Contr.
B.K.C.	3234			Lewis Drlg.
Ce.				Tools
C.				Pool
M.				Potter
M.				
K.				
Mz.				
Ma.				
V.				
S.				
S.				
A.				
R.				
Pe.				
G.				

2
 FIRST REPORT
 SEP 11 1957

Date Comm. 9-2-57

8" @ 953 W/450, Drlg. 3261

No. Sec. T. R.

County Elms Elev. 1764 DF
 Sec. 29 Twp. 11S Rge. 16W
 Company Franco Central Oil
 Farm Name Potter No. 7

TOPS	DEPTH	LOG	DATUM	Loc. in Sec.
Anb.	933			SW NW NE
Tp.		2604		
H.	2922	2920		
Tr.	2945	2943		
Dg.				
Bl.				
L. K.C.	2972	2970		Geol.
K.C.				Contr.
B.K.C.	3234	3232		Lewis Drlg.
Ce.				Tools
C.				Pool
M.				Potter
M.				
K.				
Mz.				
Mo.				
V.				
S. 54		3263		
S.				
A.		3275		
R.				
PE.				
G.				
TD.	3348			

NOV 6 57	
COMPLETE	

Date Comm. 9-2-57

8" @ 953 w/450, Drlg. 3261 SEP 18 57

Chd 3261-3307 total rec

Bwh Log 5 1/2 3346 MICT

LO 40/3276-96

9 1/2 Boph no W 3 hrs 80' Bwh

TU 2400' o.i. NW 12 hrs

POP

OCT 9 57

OCT 15 57

OCT 22 57

OCT 29 57

NOV 6 57

205 BOPD

Arb 3276-96