


Ellis

KANSAS

SECTION 29 TOWNSHIP 11S RANGE 16W

WELL NO. #8 Potter

COMPANY Franco Central

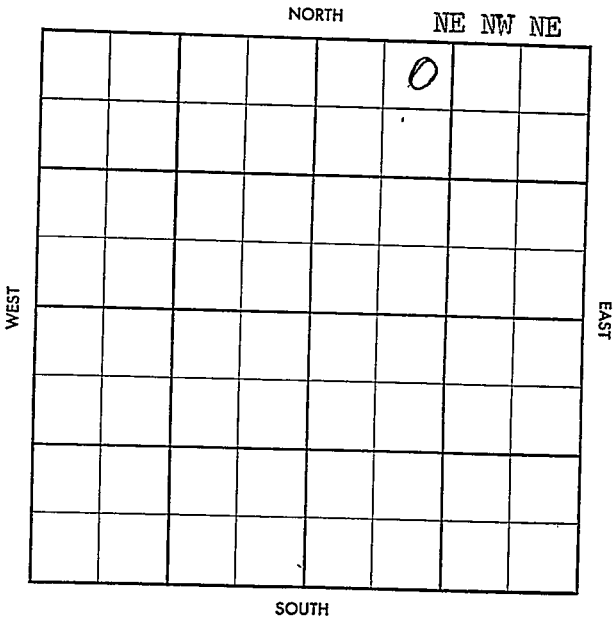

County Ellis

Elev. _____

Sec. 29 Twp. 11

Rge. 16W

Company Franco Central

FarmName Potter

No. 8

Co.

TOPS	DEPTH	LOG	DATUM
Anh.	919		
TP.			
H.			
Tr.			
Dg.			
BL.			
L.			
K.C.			
B.K.C.			
Ce.			
C.			
M.			
M.			
K.			
Mz.			
Me.			
V.			
S.			
S.			
A.			
R.			
Pe.			
G.			
T.D.			

Loc. in Sec. NE NW NE


Geol. _____

Contr. _____

Lewis Drlg.

Pool _____

Potter

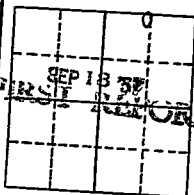

Sec.

Twp. No.

Sec.

T.

R.

Date Comm. 9-13-57

8" @ 938, Drlg. 2380

County Elk Elev. 1744 DF
 Sec. 29 Twp. 11 Rge. 16W
 Company Franco Central
 FarmName Potter No. 8

TOPS	DEPTH	LOG	DATUM	Loc. in Sec
Anb.	919			NE NW NE
Tr.	2906			
Dg.	2729			
Bl.				
L.	2957			Geol.
K.C.				Contr.
B.K.C.	3220			Lewis Drlg.
Ce.				Pool
C.				Potter
M.				
M.				
K.				
Mz.				
Me.				
V.				
S.	3252			<div style="border: 1px solid black; padding: 5px; text-align: center;"> NOV 6 57 COMPLETE </div>
S.				
A.	3264			
R.				
Pe.				
G.				
T.D.	3339			

Date Comm. 9-13-57

8" @ 938, Drlg. 2380 *ELF 5 WY LOS/PIPE*

3250, fishing 0" 57 Row log

52" 3337 00" 9 OCT 9 57 CO

120/3265-92 FV 1500' oi' NW

1 hr of 18 BOPh. NW 1000' OB

F.V. 2551' Fld 12h + 5 POP

OCT 57

POT P 240 BO NW

Act 3265-92