

KANSAS

Russell


FORM 51 5M 1-42 PETROL

Section 29 Township 11 Range 15-W

Well No. 3 Booth "B"

Company Stanolind

NORTH Fairport Pool

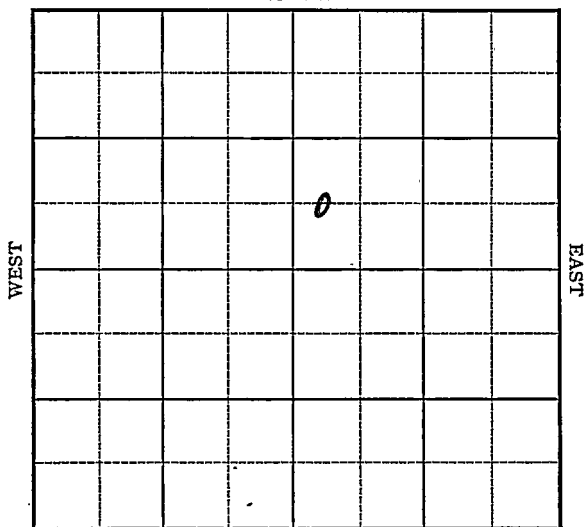

SOUTH

O.W.W.O.

KANSAS

Russell



Sec. 29 Twp. 11 R. 15-W

Well No. #3 Booth "B" Farm

Stanolind

Company

(Fairport)


Ft. from N. Line

660 Ft. from S. Line

Ft. from E. Line

330 Ft. from W. Line

Elev. 1800

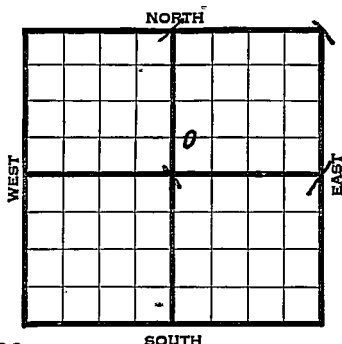

1942	REPORT
2/11	Location
2/19	"
2/26	"
3/5	"
3/12	Spud 120'
3/19	16" - 337' 13" - 557' WOC.
3/26	Anhy 855' 10" - 866' Drlg. 1405'
4/2	Drlg. 2205'
4/8	8" - 2451' Drlg. 2490'
4/15	8" - 2604' Topeka 2607'
	Dodge 2875' Drlg. 2913'
4/22	Lans. 2903' 7" - 3010'
	Pay 3094-98' T.D. 3107'
	Swab 4 oil per hour. U.R. 7".
4/29	7" - 3102' *Swab 4 oil per hour.
	T.D. 3195' U.R. 7".
5/6	Sooy 3232' 7" - 3229' H.F.W. 3295'
	T.D. 3306' SD.
5/13	Arb. 3295-3345' T.D. P.B. to 3240'
	7" - 3232' WOC.
	OVER

1942
5/20

P.B. to 3206' 36 shots 3093-3100'
500 acid. Pump 324 oil & 70 water 24
hours.

5/27

" " "

6/3

" " "

6/10

" " "

6/17

Lans. 2903'
Arb. 3295'
7" - 3232'
T.D. 3345'
P.B. to 3206'
48 shots 3120-30'
36 " 3093-3100'
5000 acid.
Pump 342 oil & 7 water.
38. Gravity

COMPLETED

1950
10/4

O.W.W.O.

Top 2607
OTD 3345 in Arb
PB 2895
112/2810-43 2000 A
P/18 BO 84 bwpd
Completed

FIRST REPORT

COMPLETED

Russell


KANSAS

Map No. 72 Sec. 29 Twp. 11 R. 15WWell No. 3 Booth "B"Stanolind CompanyFIRST REPORT Contractor

C WL SW NE

 Ft. from N. Line660 Ft. from S. Line Ft. from E. Line330 Ft. from W. Line

SECTION PLAT

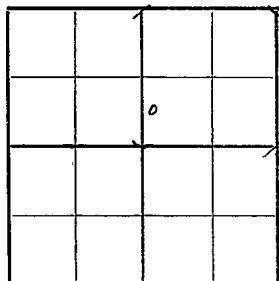

FAIRPORT POOL

Location XXXRig up

Drilling and Remarks:

RECORD

Cased in., ft.Sand Gas Oil Total Depth

PRODUCTION

1st 24 hrs. Nat. 1st 24 hrs. after shot Gas Cu. Ft.Dry Hole Abandoned

Date

FEB 11 1942 19 S. J. LEWIS Scout

Russell

Map No. 72 Sec. 29 Twp. 11 R. 15WWell No. 3 Booth "B"Stanolind Company**COMPLETED**

Contractor

C WL SW NE

SECTION PLAT

 Ft. from N. Line660 Ft. from S. Line Ft. from E. Line330 Ft. from W. Line

		0	

FAIRPORT POOL

Location Rig up

Drilling and Remarks:

*Lions 2903**CR Y3295**7" Q3232**PB 8206**482 hrt to 3120-30**36 " 3093-3100**5000 acd**Pump 842 nit + 7M**35°/hr*

RECORD

Cased in., ft.Sand Gas Oil Total Depth 3345

PRODUCTION

1st 24 hrs. Nat. 1st 24 hrs. after shot Gas Cu. Ft.Dry Hole Abandoned

Date

JUN 17 1942 19

S. J. LEWIS Scout

County Russell State KansasSec. 29 (Blk. Twp.) 11 (Sur. Rge.) 15W Map No.Operator StanolindWell No. 3 Farm F. BoothElev. Location C W I. SW NE

FIRST REPORT
6
COMPLETE

660 Ft. From S Line NE330 Ft. From W Line Quarter1st. Report OCT 4 1950Completion OCT 4 1950Remarks OWFO

Spudding Date

Drlg. Data Oil well TD 2895Top. 2607 OTD 3345 in Arb. PB 2895112/ 2810-43 2000 A P/ 18 bo 84 bwpdComp.

J. E. TYRA