


Section 29 Township 11~ Range 15-W

Well No. #4 Dodge "B"

Company Summit Oil

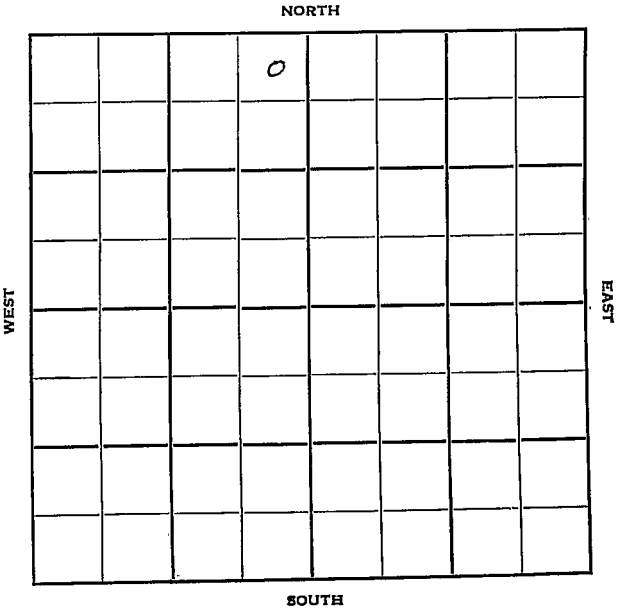

Sec. 29 Twp. 11 R. 15W 1

Well No. #4 Dodge "B" Farm

Summit Oil Company

Stearns Drlg. - Contr. Contractor

Fairport Pool


330' Ft. from N. Line

Ft. from S. Line

330' Ft. from E. Line

Ft. from W. Line

NE NE NW

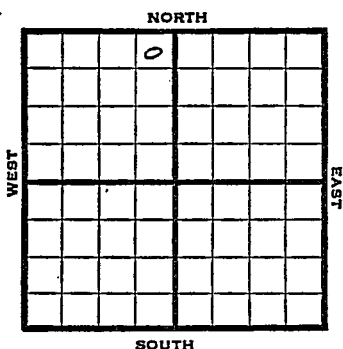

1950 Elev. 1829' REPORT

9/6 Spud 8-27-50
8-5/8" @ 582'
Anhy 905-35'
Drlg. 2317'

10/11 Spud 8-27-50
Oil Well TD 3319½
8-5/8" @ 582' Anhy 905-35
KC 2944' Arb. 3305'
TD 3319½ 5" @ 3308' 500 A
water SP 3302 36/3283-95
SP 3220 24/3158-66 SO 500 A
S/1 boph SP 3144 36/3129-41
1000 A S/2 boph DP 3144
Comp. 81 bopd

COMPLETED

County Russell State KansasSec. 29 (Blk.) 11 (Sur.) 15W Map No.Operator Summit OilWell No. 4 Farm Dodge "B"Elev. 1829 Location NE NE NW

			0			

330 Ft. From N Line NW330 Ft. From E Line Quarter1st. Report SEP 6 1950

Completion _____

Remarks _____

Spudding Date 8-27-50Drlg. Data Fairport Pool8 5/8" @ 582 Anhy 905-35 drlg. 2317

J. E. TYRA

County Russell State Kansas

Sec. 29 (Blk. Twp.) 11 (Sur. Rge.) 15^W Map No.

Operator Summit Oil

Well No. 4 Farm Dodge "B"

Elev. 1829 Location NE NE NW

0

COMPLETE

330 Ft. From N Line NW

330 Ft. From E Line Quarter

1st. Report

Completion OCT 11 1958

Remarks Fairport Pool

Stearns Drlg. - Contr.

Spudding Date 8-27-50

Drig. Data Oil well TD 3319 $\frac{1}{2}$

8 5/8" @ 582 Anhy 905-35 KC 2944

Arb. 3305 TD 3319 $\frac{1}{2}$ 5" @ 3308 500 A

water SP 3302 36/ 3283-95 SP 3220

24/ 3158-66 SO 500 A S/ 1 boph

SP 3144 36/ 3129-41 1000 A S/ 2 boph

DP 3144 Comp. 81 bopd

J. E. TYRA