

# KANSAS


Russell

Section 29 Township 11 Range 15W

Well No. 5 Dodge

Company Sumit Oil

Fairport  
NORTH

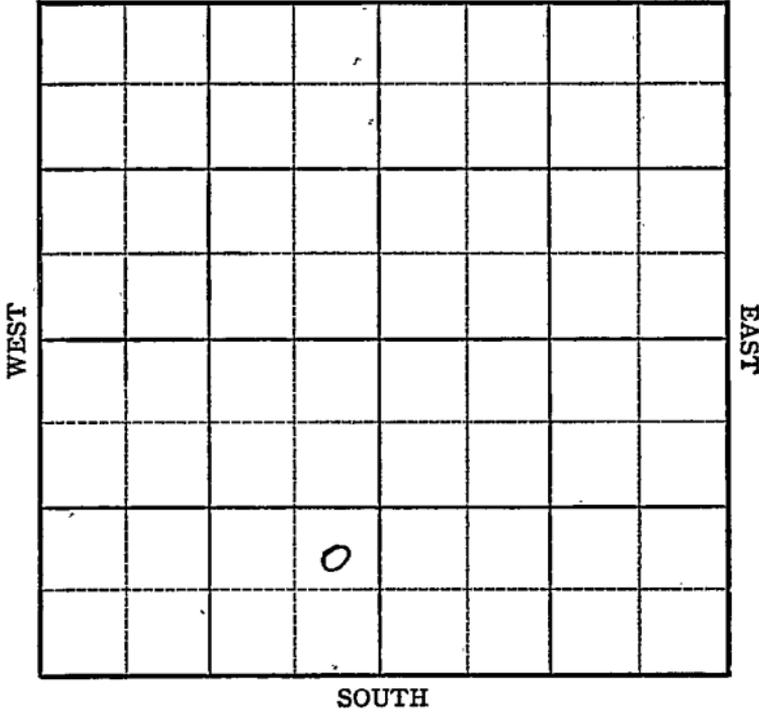

KANSAS

Russell



Sec. 29 Twp. 11 R. 15W

Well No. #5 Dodge Farm

Sumit Oil

Company


Fairport

\_\_\_\_\_ Ft. from N. Line

990' \_\_\_\_\_ Ft. from S. Line

330' \_\_\_\_\_ Ft. from E. Line

\_\_\_\_\_ Ft. from W. Line

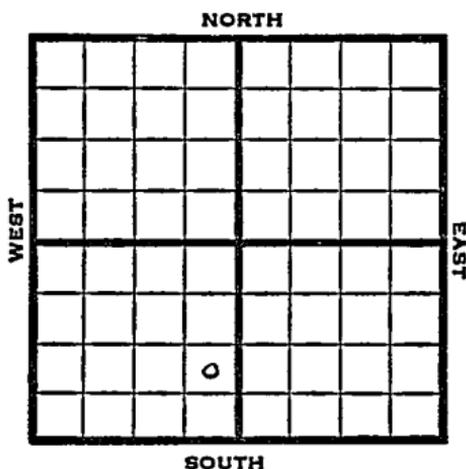

NE SE SW

1949

Elev. 1835'

REPORT

3/23	Cable
3/30	Rig
4/6	"
4/12	"
4/20	"
4/27	Spud
5/4	15" @ 344' Drlg 460'
5/10	12" @ 558' Drlg 900'
5/18	10" @ 900' Drlg 1605'
5/25	Drlg 2175'
6/1	8" @ 2405' Drlg 2490'
6/7	Drlg. 2880'
6/15	Drlg 2970'
6/21	SD 8" @ 2675'
6/28	Lansing 2950' TD 2951' Run 7" T
7/6	3077 Run 7"
7/12	3077 fsg 7"
7;20	"
7/27	"

VER

1949

8/3 3077 fsg 7"

8/10 "

8/17 "

8/24 "

8/31 "

9/7 "

9/14 "

9/21 "

9/28 "

10/5 "

10/12 "

10/19 TD 3077'

Lansing 2950'

7" @ 3000'

Pump 35 Oil / 10% W Pot

36° Gr.

Comp

**COMPLETED**

Map No. \_\_\_\_\_ Sec. 29 Twp. 11 R. 15W

Well No. 5 Dodge

Sumit Oil Company

**FIRST REPORT** Contractor

NE SE SW

**SECTION PLAT**

\_\_\_\_\_ Ft. from N. Line

990 Ft. from S. Line

330 Ft. from E. Line

\_\_\_\_\_ Ft. from W. Line


Russell County

Location \_\_\_\_\_

Rig up \_\_\_\_\_

Drilling and Remarks:

Cable \_\_\_\_\_

**RECORD**

Cased \_\_\_\_\_ in., \_\_\_\_\_ ft.

Sand \_\_\_\_\_

Gas \_\_\_\_\_

Oil \_\_\_\_\_

Total Depth \_\_\_\_\_

**PRODUCTION**

1st 24 hrs. Nat. \_\_\_\_\_

1st 24 hrs. after shot \_\_\_\_\_

Gas \_\_\_\_\_ Cu. Ft.

Dry Hole \_\_\_\_\_

Abandoned \_\_\_\_\_

Date

MAR 23 1949 19

S. J. LEWIS

Scout

Map No. \_\_\_\_\_ Sec. 29 Twp. 11 R. 15W

Well No. 5 Dodge

Sumit Oil Company

COMPLETE Contractor

NE SE SW

*E. 1185*  
SECTION PLAT

\_\_\_\_\_ Ft. from N. Line

990 Ft. from S. Line

330 Ft. from E. Line

\_\_\_\_\_ Ft. from W. Line

	0		

Russell County

Location \_\_\_\_\_

Rig up \_\_\_\_\_

Drilling and Remarks:

*Loss 2950*

*7" @ 3000*

*Prod. 35 oil + 10%*

*W.P.T.*

*31.9.30*

RECORD

Cased \_\_\_\_\_ in., \_\_\_\_\_ ft.

Sand \_\_\_\_\_

Gas \_\_\_\_\_

Oil \_\_\_\_\_

Total Depth 3077

PRODUCTION

1st 24 hrs. Nat. \_\_\_\_\_

1st 24 hrs. after shot \_\_\_\_\_

Gas \_\_\_\_\_ Cu. Ft.

Dry Hole \_\_\_\_\_

Abandoned \_\_\_\_\_

Date

OCT 19 1949

19

S. J. LEWIS

Scout