


Section 29 Township 11 Range 15 WWell No. # 1 Fairport (Swd)Company Sohio

NORTH

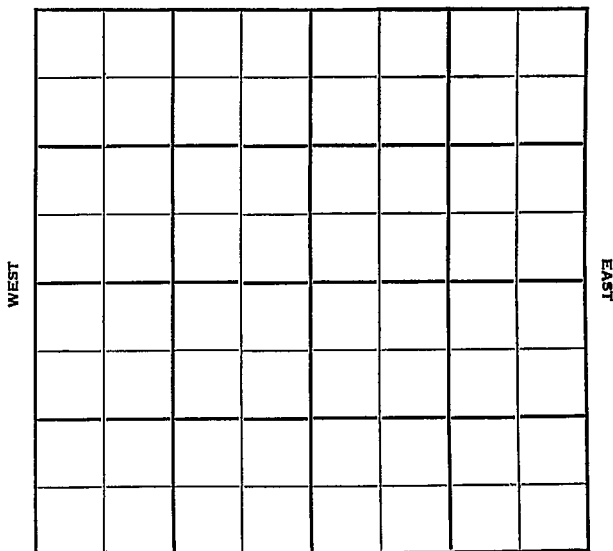

SOUTH

Russell

KANSAS

Sec. 29 Twp. 11 R. 15W

Well No. #1 Fairport (Swd.) Farm

Sohio Company

Stearns Drlg. -Contr. Contractor


 Ft. from N. Line

980'
433' Ft. from S. Line

 Ft. from E. Line


1093' Ft. from W. Line

NE SW NE

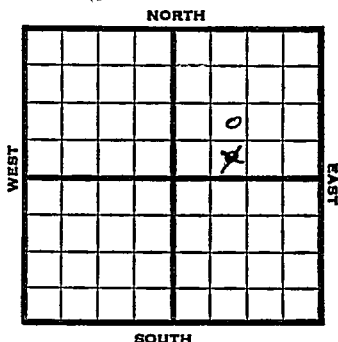

1951	Elev. 1769'	REPORT
7/3	8" @ 845 Spud 6-29-51	
8/1	Spud 6-29-51 SWD well TD 3465' 8" @ 845' TD 3463' 5" @ 3295' PB 3264' Heeb 2838' Lans 2888' Cong 3207' Arb. 3258' Basal s and 3283' Pre Cam. 3295' Granite 3463' TD 3465' Comp. for SWD well Input 36 BSWPH	
	ABANDONED	

8th @ 845th

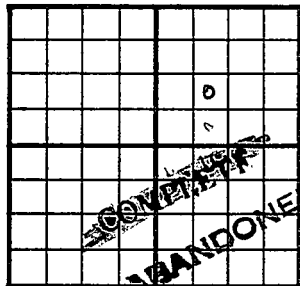County Russell State KansasSec. 29 (Blk.) 11 (Sur.) 15W Map No.Operator SohioWell No. 1 Farm Fairport SWDElev. 1769 Location NE SW NE780 Ft. From S Line NE1093 Ft. From W Line Quarter

1st. Report

Completion AUG 1 1951

Remarks

Stearn Drlg. - Contr.Spudding Date 6-29-51Drlg. Data SWD well TD 34658" @ 845 TD 3463 5" @ 3295 PB 3264Heeb. 2838 Lans. 2888 Cong. 3207Arb. 3258 Basal sand 3283 Pre-Cam. 3295Granite 3463 TD 3465Comp. for SWD well Input 36 bswph