

AS

Ellis


FORM 51 5M PETROL

Section 29 Township 11 Range 18W

Well No. #4 Johnson


Company Champlin Ref.

Riverview Pool

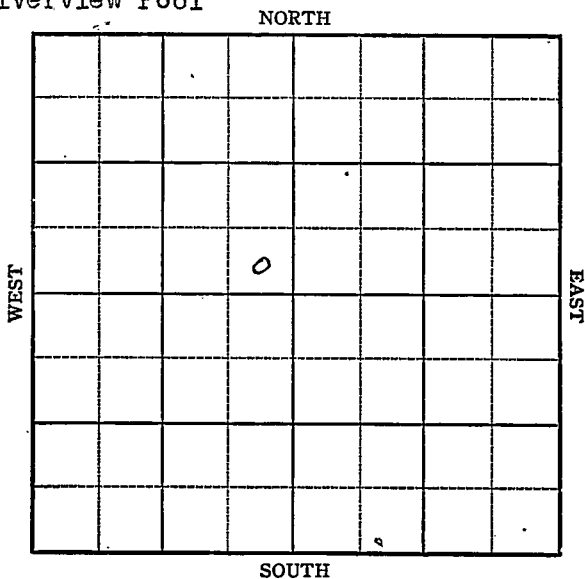

Sec. 29 Twp. 11 R. 18WWell No. #4 Johnson FarmChamplin Refg. Company

NORTH

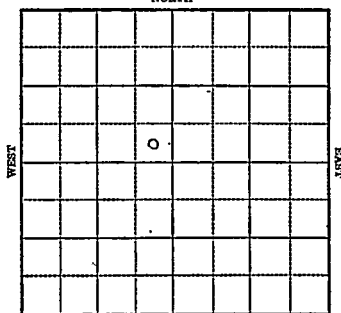

SOUTH

 Ft. from N. Line330 Ft. from S. Line330 Ft. from E. Line Ft. from W. Line*Elev. 2005*

1943

R E P O R T

12-22	Location
12/29	Surface hole
1944	
1-5	10" @ 1210 Drlg 3005'
1-12	Arb 3538 TD 3545 4" @ 3539 WOC
1/19	" "
1/26	TD 3547 Swb 40 oil in 8 hrs.
2/2	300 acid Nestest.
2/8	" "
2/15	" "
2/23	" "
3/1	" "
3/7	" "

OVER

1944

3/15 Arb 3538
4" @ 3539
TD 3547
Pump 261 Pot.
Gravity 34.0

COMPLETED

KANSAS

Map No. 71 Sec. 29 Twp. 11 R. 18WWell No. 4 Johnson

Champlin Ref.


Company

FIRST REPORT

Contractor

SE NW

SECTION PLAT

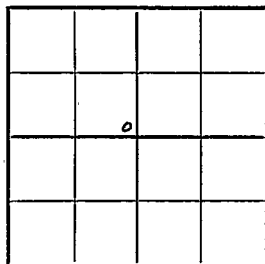

_____ Ft. from N. Line

330

_____ Ft. from S. Line

330

_____ Ft. from E. Line

_____ Ft. from W. Line

Riverview Pool

Location X

Rig up _____

Drilling and Remarks:

RECORD

Cased _____ in., _____ ft.

Sand _____

Gas _____

Oil _____

Total Depth _____

PRODUCTION

1st 24 hrs. Nat. _____

1st 24 hrs. after shot _____

Gas _____ Cu. Ft.

Dry Hole _____

Abandoned _____


Date

DEC 22 1943

19

S. J. LEWIS

Scout

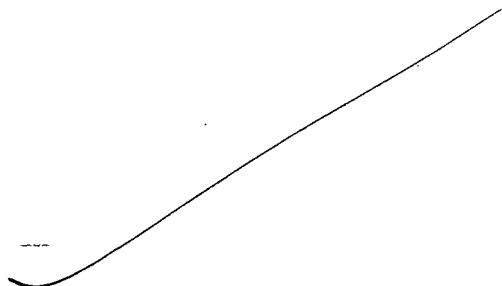


Misc Small Maps *Omaha*
Cards *Madge*
Tracing *MEZ*
France Map *MEZ*
Scarborough Map *MEZ*
Moody Map *MEZ*
Geological Dept
Moody Plat Book

KANSAS

Map No. 71 Sec. 29 Twp. 11 R. 18WWell No. 4 JohnsonC hamplin Ref. CompanyCOMPLETED Contractor

SE NW

SECTION PLAT

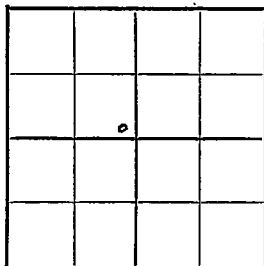 Ft. from N. Line330 Ft. from S. Line330 Ft. from E. Line Ft. from W. Line

Riverview Pool

Location Rig up

Drilling and Remarks:

*Ar 83538**4" C 83539**Run 4/26/44**34° S*

RECORD

Cased in., ft.Sand Gas Oil Total Depth 3547

PRODUCTION


1st 24 hrs. Nat. 1st 24 hrs. after shot Gas Cu. Ft.Dry Hole Abandoned

Date

MAR 15 1944 19

S. J. LEWIS

Scout

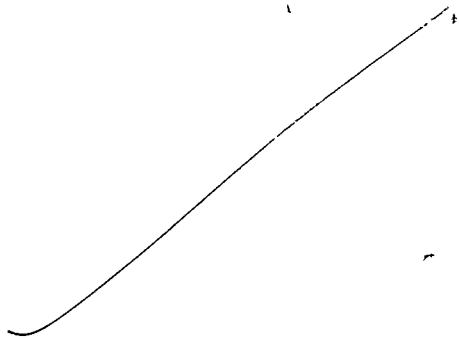

Misc. Small Maps	<i>Om</i>
Cards	<i>Severly</i>
Tracing	<i>M J L</i>
France Map	<i>✓</i>
Scarborough Map	<i>✓</i>
Moody Map	<i>M J L</i>
Geological Dept.	
Moody Plat Book	