


Section 29 Township 11 Range 18-W

Well No. #2 Johnston


Company Champlin Oil & Refining

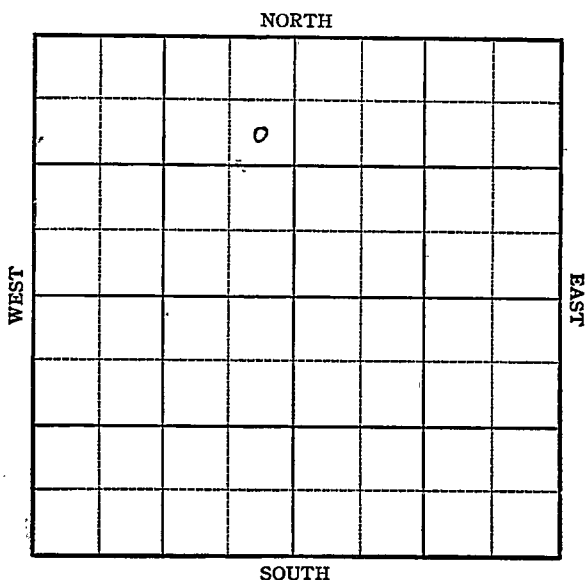

3

KANSAS

Ellis

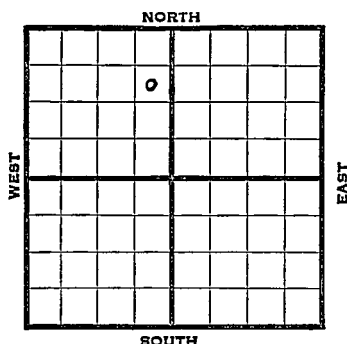Sec. 29 Twp. 11 R. 18-WWell No. #2 Johnston FarmChamplin Oil & Refining Company990 Ft. from N. Line Ft. from S. Line330 Ft. from E. Line Ft. from W. LineELEV. 2044

1943	REPORT
9/1	Location
9/8	Surface hole
9/15	10" @ 1255'
	Drlg. 2260'
9/22	Drlg. 3104'
	Anhy 1340'
9/29	Arb 3589
	T.D. 3578'
	Run Csg.
10/6	Arb. 3585 Corrected
	4 " @ 3586'
	T.D. 3589'
	1850' oil in 6 hrs.
10/13	500 acid to reacidize
10/20	Pumping 112 Temp pot.
10/27	" " " "
11/3	Reacidize
	OVER

1943
11/10

Arb 3585
4" @ 3586'
1000 acid
Pump 2700 Pot.
T.D. 3589
Gravity 26

COMPLETED

KANSAS

Map No. 7-1 Sec. 29 Twp. 11 R. 18WWell No. 2 JohnstonChamplin Oil & Refining Company


FIRST REPORT

Contractor

SE NE NW

990 Ft. from N. Line Ft. from S. Line330 Ft. from E. Line Ft. from W. Line

SECTION PLAT

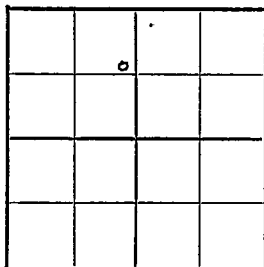Riverview PoolLocation XRig up

Drilling and Remarks:

RECORD

Cased in., ft.Sand Gas Oil Total Depth

PRODUCTION

1st 24 hrs. Nat. 1st 24 hrs. after shot Gas Cu. Ft.Dry Hole Abandoned

Date

SEP 1 1943 19S. L. LEWIS Scout

Misc Small Maps

Cards

Trading

France Map

Scarborough Map

Moody Map

Geological Dept.

Moody Flat Book

KANSAS

Map No. Sec. 29 Twp. 11 R. 18WWell No. 2 JohnstonChamplin Oil & Ref.

Company

COMPLETED

Contractor

SE NE NW

SECTION PLAT

990 Ft. from N. Line

Ft. from S. Line

330 Ft. from E. Line

Ft. from W. Line

Riverview PoolLocation Rig up

Drilling and Remarks:

*Cr 43585**4" @ 3586**1000 acid**Pump 2700 Pst**260 Gr*

RECORD

Cased in., ft.Sand Gas Oil Total Depth 3586

PRODUCTION

1st 24 hrs. Nat. 1st 24 hrs. after shot Gas Cu. Ft.Dry Hole Abandoned


Date

NOV 10 1943

19

S. J. LEWIS

Scout

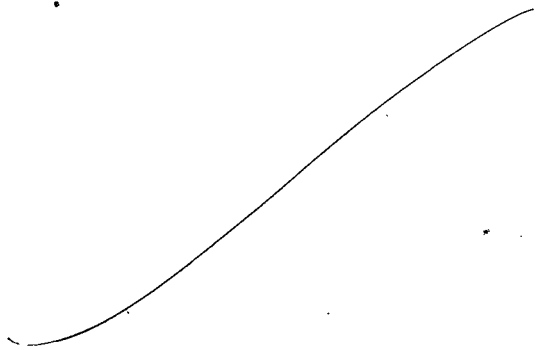

I. 30. Small Map	<i>Oma</i>
Cares	<i>Madge</i>
Tracing	<i>Madge</i>
Franco Map	☒
Scarborough Map	☒
Pierce f. on	<i>Madge</i>
Geological Dept.	
Pierce Plat Cook	