

Sec. 29 Twp. 11 R. 18-W

Well No. #2 Johnston "E" Farm


Champlin Ref. Company

660 Ft. from N. Line

_____ Ft. from S. Line

_____ Ft. from E. Line

465 Ft. from W. Line

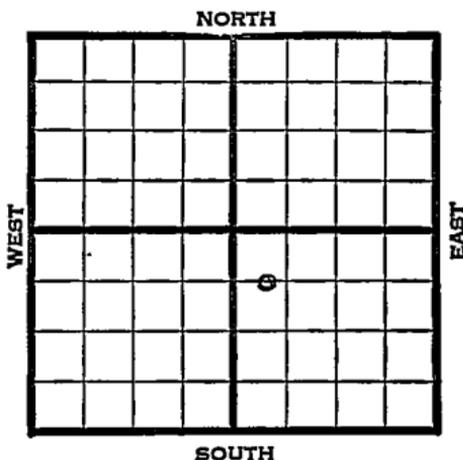

C NW SE Elev. 1976

1945

REPORT

8/29 8" @ 1200'
Drig. 1990'

9/5 Lans 3275
Drig. 3305

9/12 Lans 3243 corrected
Cong 3474
Simp 3480
Arb. 3502
TD 3508

9/19 5" @ 3503' RUST
TD 3508
14½ oil per hr. 7 hrs.

9/26 " " " "

10/3 Arb. 3502
5" @ 3503
TD 3508'
Pump 300 Pot.
Grav. 31.0

COMPLETED

KANSAS ~~Kansas~~ Pool Name RiverviewMap No. 71 Sec. 29 Twp. 11 R. 18WWell No. 2 Johnston "E"~~Champlin~~ Ref. _____ Company _____

COMPLETED

Contractor

E. J. 1976

SECTION PLAT

C NW SE

660 Ft. from N. Line

_____ Ft. from S. Line

_____ Ft. from E. Line

465 Ft. from W. Line

Ellis County

Location _____

Rig up _____

Drilling and Remarks:


RECORD

Cased _____ in., _____ ft.

Sand _____

Gas _____

Oil _____

Total Depth 3508

PRODUCTION

1st 24 hrs. Nat. _____

1st 24 hrs. after shot _____

Gas _____ Cu. Ft.

Dry Hole _____

Abandoned _____

Date

OCT 3 1945 19S. J. LEWIS Scout

Section 29 Township 11 Range 18W

Well No. 2 Johnston "E"

Company Champlin Ref.

