

KANSAS


Ellis

FORM 51 5M 10-41 PETROL

Section 29 Township 11 Range 17-W

Well No. #1 Hadley K

Company Champlin Refg.

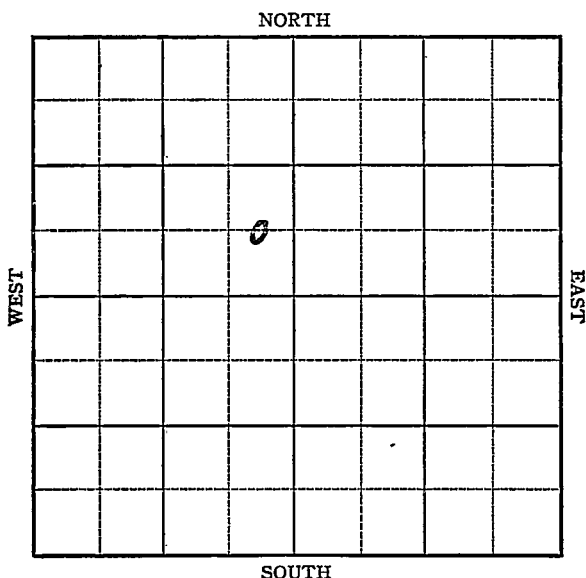

KANSAS

Ellis

Sec. 29 Twp. 11 R. 17-W

Well No. #1 Hadley K Farm

Champlin Refg. Company
(Bemis) NORTH


Ft. from N. Line

660 Ft. from S. Line

330 Ft. from E. Line

_____ - Ft. from W. Line

Elev. 2000

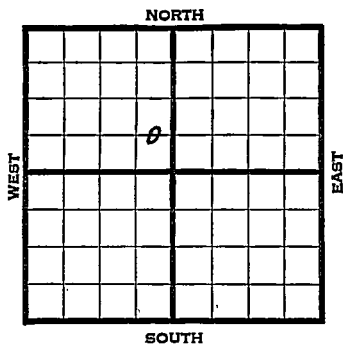

1942	REPORT
5/6	Location
5/13	Anhy 1195' 8" - 1210' Drlg. 2505'
5/20	Drlg. 3000'
5/27	No report.
6/3	Arb. 3493' 4" - 3524' T.D.
	72 shots 3496-3511 $\frac{1}{2}$ ' 2000 acid.
	Swab 15 oil per hour.
6/10	Arb. 3493'
	4" - 3524'
	T.D. 3524'
	72 shots 3496-3511 $\frac{1}{2}$ '
	2000 acid.
	Potential 300 bbls., pump.
	34. Gravity
	COMPLETED

Map No. 71 Sec. 29 Twp. 11 R. 17WWell No. 1 Hadley KChamplin Refining Company**FIRST REPORT**

Contractor

C EL SE NW

SECTION PLAT

	o		

 Ft. from N. Line660 Ft. from S. Line330 Ft. from E. Line Ft. from W. Line

BEMIS POOL

Location XXRig up

Drilling and Remarks:

RECORD

Cased in., ft.Sand Gas Oil Total Depth

PRODUCTION

1st 24 hrs. Nat. 1st 24 hrs. after shot Gas Cu. Ft.Dry Hole Abandoned

Date

MAY 6 1942 19 S. J. LEWIS Scout

Map No. 71 Sec. 29 Twp. 11 R. 17WWell No. 1 Hadley "K"Champlin Refining CompanyCOMPLETED Contractor

C EL SE NW

SECTION PLAT

 Ft. from N. Line660 Ft. from S. Line330 Ft. from E. Line Ft. from W. Line

BEMIS POOL

Location Rig up

Drilling and Remarks:

*Ar 83493**4" @ 3524**722 h to 3496 - 951 1/2**2000 acid**Pump 300 R x**340 g*

RECORD

Cased in., ft.Sand Gas Oil Total Depth 3524

PRODUCTION

1st 24 hrs. Nat. 1st 24 hrs. after shot Gas Cu. Ft.Dry Hole Abandoned

Date

JUN 10 1942 19S. J. LEWIS Scout