

KANSAS

Form 51-5M-7-40-Palace

Ellis


Section 29 Township 11 Range 17-W

Well No. 3 Glatheart

Company Champlin Refining

NORTH

Marshall Pool

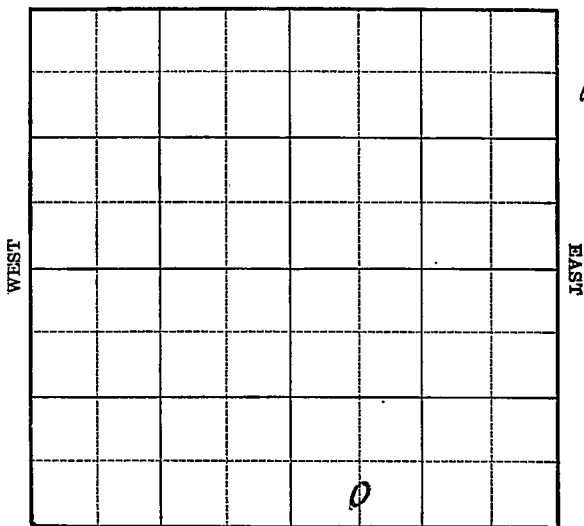

SOUTH

Sec. 29 Twp. 11 R. 17-W

Well No. #3 Glatheart Farm

Champlin Refining Company

(Marshall)


_____ Ft. from N. Line

330 Ft. from S. Line

_____ Ft. from E. Line

660 Ft. from W. Line

Elev. 2098

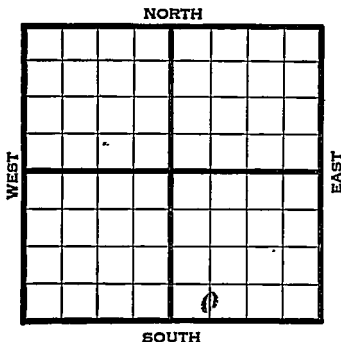

1941	REPORT
1/8	S. H.
1/16	8" - 1250' Anhy 1330'
	Drlg. 2710'
1/23	Lans. 3340' Arb. 3599'
	T.D. 3627' S.O. Shut down.
1/30	T.D. 3628' 4" - 3628' RUST.
2/6	24 shots 3605-14'
	12 shots 3614-17' 12 shots
	3617-24' 4500 acid.
2/13	P.B. to 3615'
2/19	Arb. 3599'
	4" - 3628'
	T.D. 3628'
	48 shots 3605-24'
	4500 acid.
	P.B. to 3611'
	5000 acid 3605-11'
	Potential 108 bbls., pump.
	39. Gravity

COMPLETED

Map No. 71 Sec. 29 Twp. 11 R. 17WWell No. 3 GlatheartChamplin Refining Company

Contractor

FIRST REPORT

C S L SW SE

 Ft. from N. Line330 Ft. from S. Line Ft. from E. Line660 Ft. from W. Line

MARSHALL POOL

SECTION PLAT

		o	

Location Rig up

Drilling and Remarks:

S.H.

RECORD

Cased in., ft.Sand Gas Oil Total Depth

PRODUCTION

1st 24 hrs. Nat. 1st 24 hrs. after shot Gas Cu. Ft.Dry Hole Abandoned

Date

JAN 8 1941 19S. J. LEWIS Scout

Map No. 71 Sec. 29 Twp. 11 R. 17WWell No. 3 GlatheartChamplin Refining Company

Contractor

COMPLETED

C S L SW SE

_____ Ft. from N. Line

330 Ft. from S. Line

_____ Ft. from E. Line

660 Ft. from W. Line

MARSHALL POOL

SECTION PLAT

Location _____

Rig up _____

Drilling and Remarks:

*Ar 43599**4" C 3628**48 Bld to 3605-24**4500 acid**P. B 3611**5000 acid 3605-11**Pump 108 P. X**1390 Gr.*

Date _____

RECORD

Cased _____ in., _____ ft.

Sand _____

Gas _____

Oil _____

Total Depth 3628

PRODUCTION

1st 24 hrs.-Nat. _____

1st 24 hrs. after shot _____

Gas _____ Cu. Ft.

Dry Hole _____

Abandoned _____

FEB 19 1911 19

S. J. LEWIS Scout