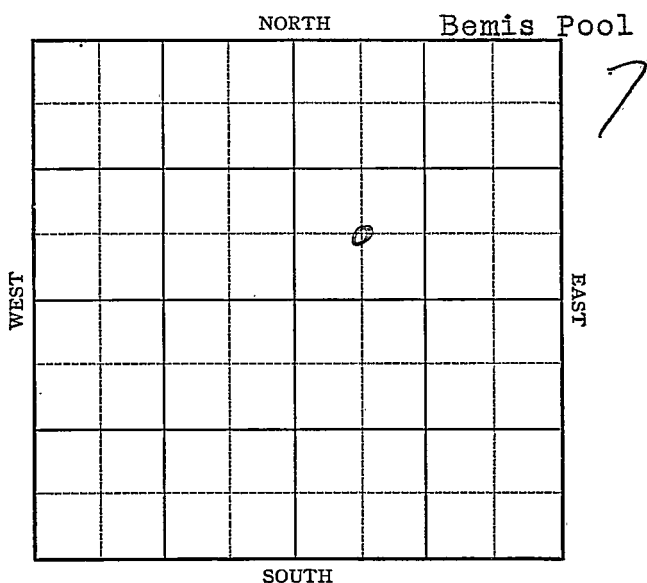


KANSAS

Ellis

FORM 51 5M 4-41 PETROL

Section 29 Township 11 Range 17-WWell No. #4 GlatheartCompany Champlin Refining

Map No. 71 Sec. 29 Twp. 11 R. 17WWell No. 4 GlatheartChamplin Refining Company**FIRST REPORT** Contractor

C SW NE

SECTION PLAT

 Ft. from N. Line660 Ft. from S. Line Ft. from E. Line660 Ft. from W. Line

		o	

BEMIS POOL

Location Rig up

Drilling and Remarks:

8" - 1303'Waiting on
cement to set

RECORD

Cased in., ft.Sand Gas Oil Total Depth

PRODUCTION

1st 24 hrs. Nat. 1st 24 hrs. after shot Gas Cu. Ft.Dry Hole Abandoned

Date

JUN 10 194219S. J. LEWIS

Scout

Ellis

KANSAS

Map No. 71 Sec. 29 Twp. 11 R. 17WWell No. 4 GlatheartChamplin Refining Company**COMPLETED**

Contractor

C SW NE

SECTION PLAT

		o	

_____ Ft. from N. Line

660 Ft. from S. Line

_____ Ft. from E. Line

660 Ft. from W. Line

BEMIS POOL

Location _____

Rig up _____

Drilling and Remarks:

None 8340Cr 835864" @ 362539s to 3610-2036 " 3670-36034000 cu ftPump 250 Ps313 1/2

RECORD

Cased _____ in., _____ ft.

Sand _____

Gas _____

Oil _____

Total Depth 3625

PRODUCTION

1st 24 hrs. Nat. _____

1st 24 hrs. after shot _____

Gas _____ Cu. Ft.

Dry Hole _____

Abandoned _____

Date

JUL 8 1942 19 S. J. LEWIS Scout