

# KANSAS


Ellis

FORM 51 5M 4-41 PETROL

Section 29 Township 1E Range 17-W

Well No. #4 Hadley "B"

Company Champlin Refining

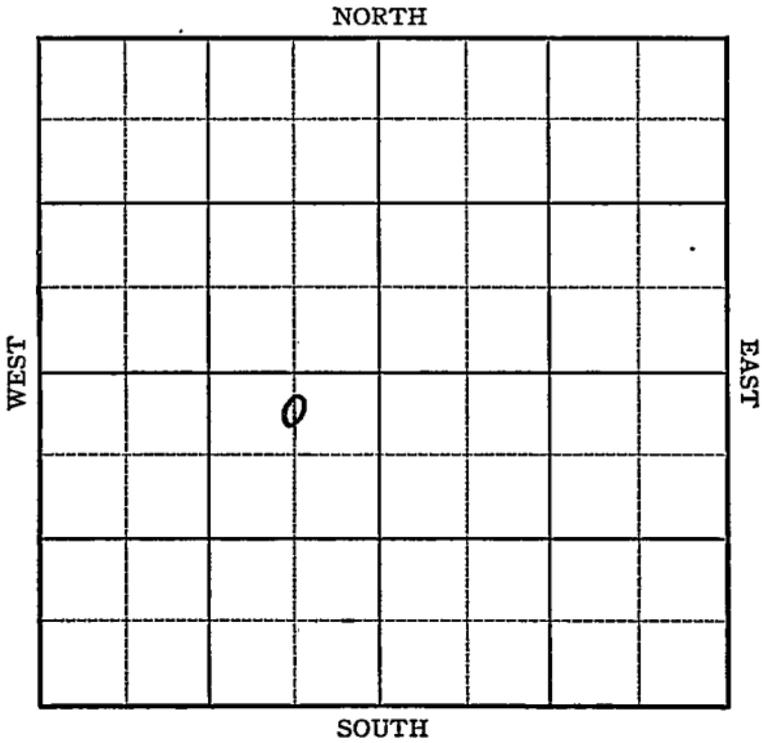

Sec. 29 Twp. 11 R. 17-W

Well No. #4 Hadley "B" Farm \_\_\_\_\_

Champlin Refg. Company \_\_\_\_\_


(Bemis)

330 Ft. from N. Line

\_\_\_\_\_ Ft. from S. Line

660 Ft. from E. Line

\_\_\_\_\_ Ft. from W. Line

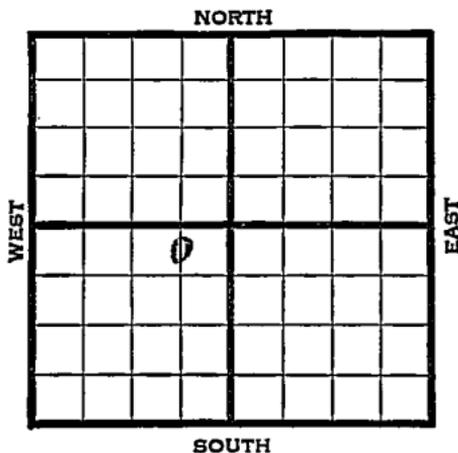

Elev. 2031

1941	REPORT
9/24	Drlg. 775'
10/2	8" - 1267' Drlg. 3066'
10/9	Anhv 1265' Arb. <del>3560</del> <sup>3534</sup> '
	4" - 3560' T.D. RUST.
10/16	" " " "
10/23	Perf. 96 shots 3532-56'
	3500 acid. Swab 108 oil.
10/29	Arb. 3534' (Corrected)
	4" - 3560'
	T.D. 3560'
	96 shots 3532-56'
	3500 acid.
	Potential 108 bbls., Pump.
	33.5 Gravity
	<b>COMPLETED</b>

Map No. K-71 Sec. 29 Twp. 11 R. 17W

Well No. 4 Hadley "B"

Champlin Refining Company

FIRST REPORT Contractor

SECTION PLAT

	o		

C WL NE SW

330 Ft. from N. Line

Ft. from S. Line

660 Ft. from E. Line

Ft. from W. Line

BEMIS POOL

Location \_\_\_\_\_

Rig up \_\_\_\_\_

Drilling and Remarks:

"

Drilling 775

RECORD

Cased \_\_\_\_\_ in., \_\_\_\_\_ ft.

Sand \_\_\_\_\_

Gas \_\_\_\_\_

Oil \_\_\_\_\_

Total Depth \_\_\_\_\_

PRODUCTION

1st 24 hrs. Nat. \_\_\_\_\_

1st 24 hrs. after shot \_\_\_\_\_

Gas \_\_\_\_\_ Cu. Ft.

Dry Hole \_\_\_\_\_

Abandoned \_\_\_\_\_

Date

SEP 24 1941

19

S. J. LEWIS Scout

Map No. K-71 Sec. 29 Twp. 11 R. 17W

Well No. 4 Hadley "B"

Champlin Refining Company

**COMPLETED**

Contractor

C NL NE SW

330 Ft. from N. Line

\_\_\_\_\_ Ft. from S. Line

660 Ft. from E. Line

\_\_\_\_\_ Ft. from W. Line

**SECTION PLAT**

	o		

**BEMIS POOL**

Location \_\_\_\_\_

Rig up \_\_\_\_\_

Drilling and Remarks:

*Core 3534 @ directed  
4" @ 3560  
96 sh to 3532-56  
3500 acid  
Pump 105 P &  
33 E 9*

**RECORD**

Cased \_\_\_\_\_ in., \_\_\_\_\_ ft.

Sand \_\_\_\_\_

Gas \_\_\_\_\_

Oil \_\_\_\_\_

Total Depth 3560

**PRODUCTION**

1st 24 hrs. Nat. \_\_\_\_\_

1st 24 hrs. after shot \_\_\_\_\_

Gas \_\_\_\_\_ Cu. Ft.

Dry Hole \_\_\_\_\_

Abandoned \_\_\_\_\_

Date

**OCT 29 1941**

19

**Sr. J. LEWIS**

Scout