


Section 29 Township 11 Range 17-W


Well No. #1 C.M. Hadley

Company Champlin Refg.

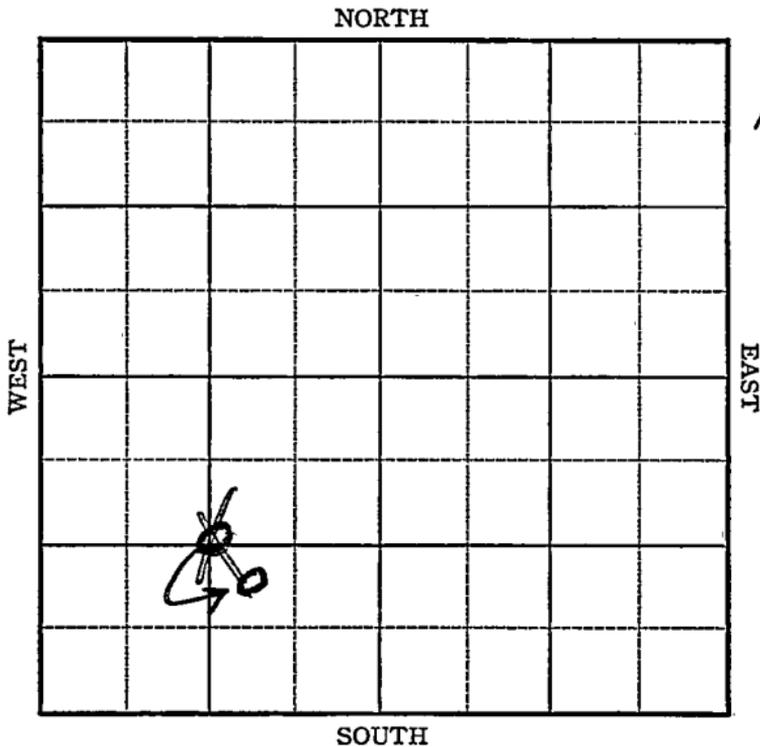

Sec. 29 Twp. 11 R. 17Well No. #1 C. M. Hadley FarmChamplin Refg. Company Ft. from N. Line990
~~1520~~ Ft. from S. Line990 Ft. from E. Line1320 Ft. from W. Line

Elev. 2020

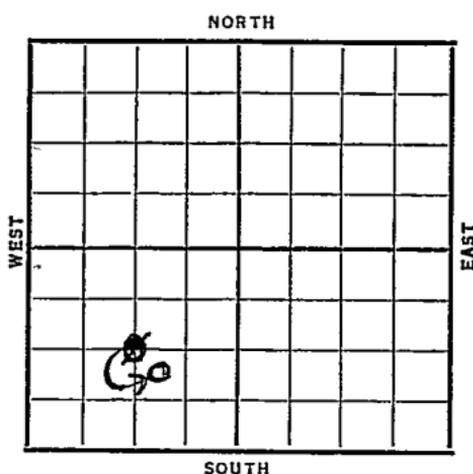

Date	REPORT
1937	
10/27	15" @ 22'. Drlg. 1500'.
11/5	Drlg. 3240'.
11/12	Sil. & 7" @ 3527'. T.D. 3535'. S.O. RUST.
11/19	50' oil 12 hrs. C.O.
11/26	1500 acid. Pump 45 bbls. oil 15 hrs. Will deepen.
12/3	T.D. 3555'. 700' oil 14 hrs. 1000 acid.
12/10	3000 acid. Swab 45 bbls. oil per hr.
12/17	" " "
12/24	Testing.
12/31	"
1938	
1/7	"

OVER

1938

1/12

7" @ 3527'.

Arb. 3527'.

T.D. 3555'.

5500 acid.

Potential 1356 bbls.

COMPLETED .

RAY

Returned _____

Cards _____

Tracing _____

France Map _____

Scarborough Map _____

Moody Map _____

Scarborough Flat Book _____

Moody Flat Book _____

Ellis KANSAS

Map No. _____ Sec. 29 Twp. 11 R. 17^w

Well No. 1 - C. M. Hadley

Champlin Ref Company

Contractor _____

CORRECTION

SECTION PLAT

_____ Ft. from N. Line
990 Ft. from S. Line
990 Ft. from E. Line
 _____ Ft. from W. Line

	6		

Location _____

Rig up _____

Drilling and Remarks:

*first reported
 as csw - should
 be nw SE SW*

RECORD

Cased _____ in., _____ ft.
 Sand _____
 Gas _____
 Oil _____
 Total Depth _____

PRODUCTION

1st 24 hrs. Nat. _____
 1st 24 hrs. after shot _____
 Gas _____ Cu. Ft.
 Dry Hole _____
 Abandoned _____

Date

NOV 3 1937 19

H. D. Hatfield Scout

Handwritten scribbles and lines, possibly representing a signature or initials.

Returned	_____
Cards	_____ <i>Paul</i>
Tracing	_____ <i>Sm</i>
France map	_____ <input checked="" type="checkbox"/>
Scarborough ...	_____
Moody ...	_____

Paul

Returned	_____
Cards	<i>Paul</i>
Tracing	<i>Jim</i>
France Map	<i>Jim</i>
Scarborough Map	<i>Paul</i>
Moody Map	_____
Scarborough Flat Book	_____
Moody Flat Book	_____