


Section 29 Township 11 Range 17-W

Well No. #4, Headley "K"

Company Champlin Refg. Company

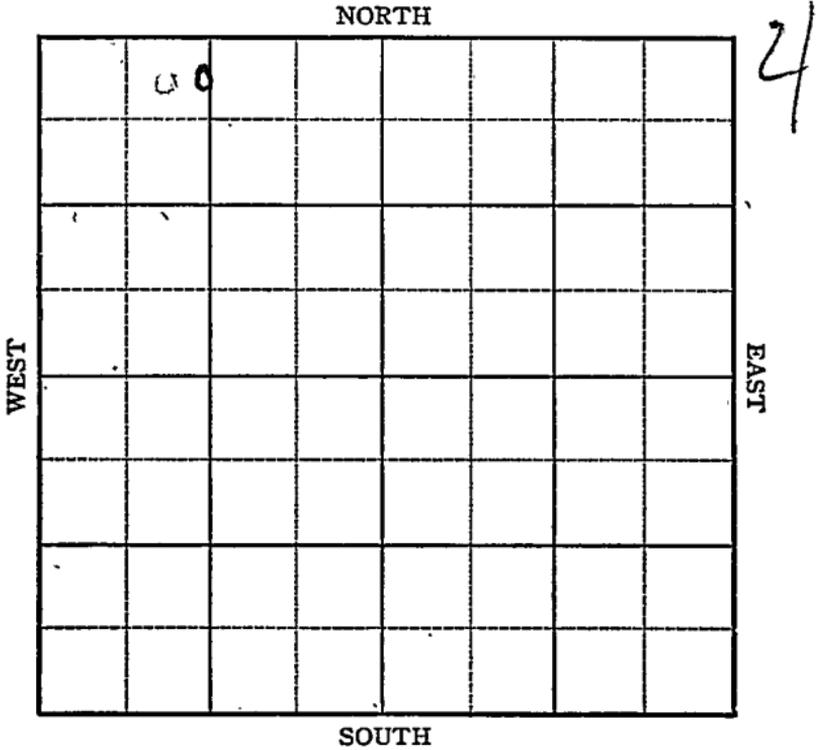

Sec. 29 Twp. 11-S R. 17-W

Well No. #4, Hadley "K" Farm \_\_\_\_\_

Champlin Ref. \_\_\_\_\_ Company \_\_\_\_\_


330' Ft. from N. Line

\_\_\_\_\_ Ft. from S. Line

\_\_\_\_\_ Ft. from E. Line

1350' Ft. from W. Line

NE NW NW

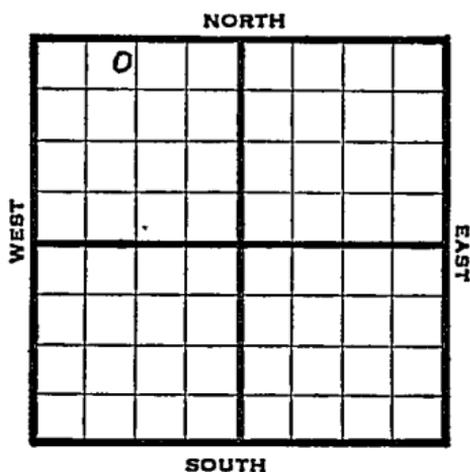

1946

1918

REPORT

9/5

Location

SWD

9/10

RUR

9/24

Drlg 3348'

10/1

Lans 3149

Arb 3442'

10/8

Drlg 3775'

"

"

10/16

Arb 3443'

Granite Wash 3897'

TD 3918'

4000 Acid

SWD

ABANDONED

KANSAS Kansas Pool Name BemisMap No. 71 Sec. 29 Twp. 11 R. 17WWell No. 4 Hadley "K"Champlin Ref. CompanyFIRST REPORT Contractor


NE NW NW

## SECTION PLAT

330 Ft. from N. Line

Ft. from S. Line

Ft. from E. Line

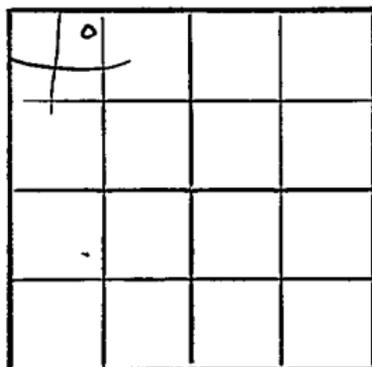1350 Ft. from W. Line

Ellis County

Location x

Rig up

Drilling and Remarks:

SWD

## RECORD

Cased \_\_\_\_\_ in., \_\_\_\_\_ ft.

Sand \_\_\_\_\_

Gas \_\_\_\_\_

Oil \_\_\_\_\_

Total Depth \_\_\_\_\_

## PRODUCTION

1st 24 hrs. Nat. \_\_\_\_\_

1st 24 hrs. after shot \_\_\_\_\_

Gas \_\_\_\_\_ Cu. Ft.

Dry Hole \_\_\_\_\_

Abandoned \_\_\_\_\_

Date

SEP 5 1946 19 S. J. LEWIS Scout

Kansas **KANSAS**

Map No. 71 Sec. 29 Twp. 11 R. 17W

Well No. 4 Hadley "K" SWD

Champlin Ref. \_\_\_\_\_ Company

**ABANDONED**

Contractor

NE NW NW

*E. 11/18*

**SECTION PLAT**

330 Ft. from N. Line

\_\_\_\_\_ Ft. from S. Line

\_\_\_\_\_ Ft. from E. Line

1350 Ft. from W. Line

60			

Ellis County

Location \_\_\_\_\_

Rig up \_\_\_\_\_

Drilling and Remarks:

*Cor 3443*  
*Granite Wash 388'*  
*4000 acid*  
*SWD*

**RECORD**

Cased \_\_\_\_\_ in., \_\_\_\_\_ ft.

Sand \_\_\_\_\_

Gas \_\_\_\_\_

Oil \_\_\_\_\_

Total Depth 3718

**PRODUCTION**

1st 24 hrs. Nat. \_\_\_\_\_

1st 24 hrs. after shot \_\_\_\_\_

Gas \_\_\_\_\_ Cu. Ft.

Dry Hole \_\_\_\_\_

Abandoned \_\_\_\_\_

Date

OCT 16 1946 19

**S. J. LEWIS**

Scout