

# KANSAS


Ellis

FORM 51 5M BR1X

Section 29 Township 11 Range 17W

Well No. #2 Madden

Company H.W. Liggett

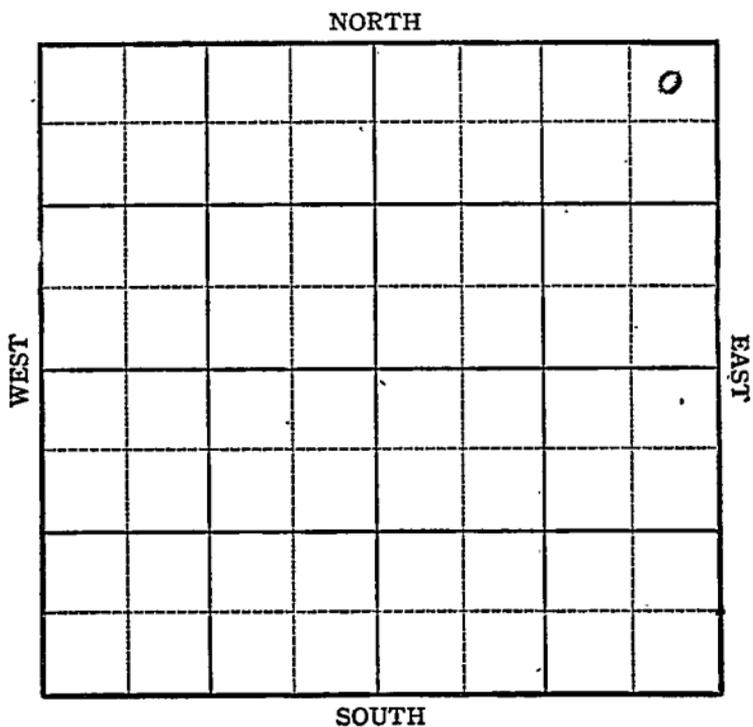

Sec. 29 Twp. 11 R. 17W

Well No. #2 Madden Farm  
H. W. Diggert Company

Bemis


NORTH

330 Ft. from N. Line

\_\_\_\_\_ Ft. from S. Line

330 Ft. from E. Line

\_\_\_\_\_ Ft. from W. Line

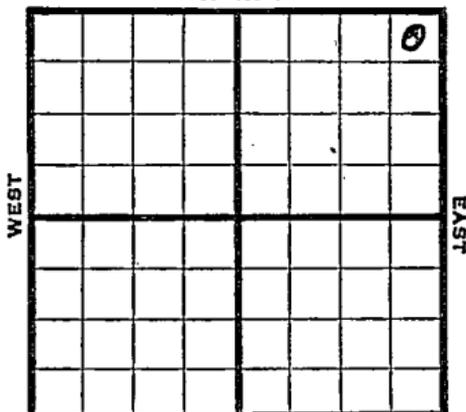

NE/c *Elev. 2042*

1945

R E P O R T

1/24	Location
1/31	"
2/7	"
2/14	R U R
2/21	8" @ 1257 Anhy Drlg 2205
2/28	2320 SD
3/7	Drlg 3105
3/14	Arb 3576-83 TD 5" @ 3576 RUST
3/23	" " W "
3/29	1000 acid. 1800' oil 2 hrs.
4/5	PB 3380 20 shots 3374-80 CO
4/12	1000 acid. 600' oil 1 hr. 18 shots 3374-3380
4/20	30 shots 3360-3364 2000' Water pqueeze
4/26	" " " " "
5/3	" " " " "
5/10	" " " " "
5/17	" " " " "
5/24	" " " " "
5/31	500 acid. PB 3576

OVER

1945

6/13

Arb  
5" @ 3575'  
TD 3628'

3576

**ABANDONED**

Pool Name BemisMap No. 91 Sec. 29 Twp. 11 R. 17WWell No. 2 MaddenH. W. Tiggett Company

## FIRST REPORT

Contractor

NE/c

## SECTION PLAT

330 Ft. from N. Line       Ft. from S. Line330 Ft. from E. Line       Ft. from W. Line


Ellis

Location XRig up       

Drilling and Remarks:

## RECORD

Cased        in.,        ft.Sand       Gas       Oil       Total Depth       

## PRODUCTION

1st 24 hrs. Nat.       1st 24 hrs. after shot       Gas        Cu. Ft.Dry Hole       Abandoned       

Date

JAN 24 1945 19S I LEWIS Scout

Misc. Small Maps.....	LR
Cards.....	LR
Tracing.....	LR
France Map.....	LR
Scarborough Map.....	LR
Moody Map.....	LR
Geological Dept.....	
Moody Plat Book.....	

Kansas Pool Name BemisMap No. 71 Sec. 29 Twp. 11 R. 17WWell No. 2 MaddenH. W. Liggett Company**ABANDONED** Contractor

NE/c

E12042  
SECTION PLAT330 Ft. from N. Line       Ft. from S. Line330 Ft. from E. Line       Ft. from W. Line

			0

Ellis County

Location \_\_\_\_\_

Rig up \_\_\_\_\_

Drilling and Remarks:

Cor 435765" C 3576

## RECORD

Cased \_\_\_\_\_ in., \_\_\_\_\_ ft.

Sand \_\_\_\_\_

Gas \_\_\_\_\_

Oil \_\_\_\_\_

Total Depth 3628

## PRODUCTION

1st 24 hrs. Nat. \_\_\_\_\_

1st 24 hrs. after shot \_\_\_\_\_

Gas \_\_\_\_\_ Cu. Ft.

Dry Hole \_\_\_\_\_

Abandoned \_\_\_\_\_

Date

JUN 13 1945 19S. J. LEWIS Scout

MA

Misc Small Maps	_____
Cards	22
Tracing	RB
France Map	✓
Scarborough Map	W
Pierce Map	RB
Geological Dept.	_____
Pierce Plat Book	_____