Form 51-5M 5-37 Petrol


Ellis

KANSAS

Section 29 Township 11 Range 17-W

Well No. 1 Madden Est

Company Twin Drlg.

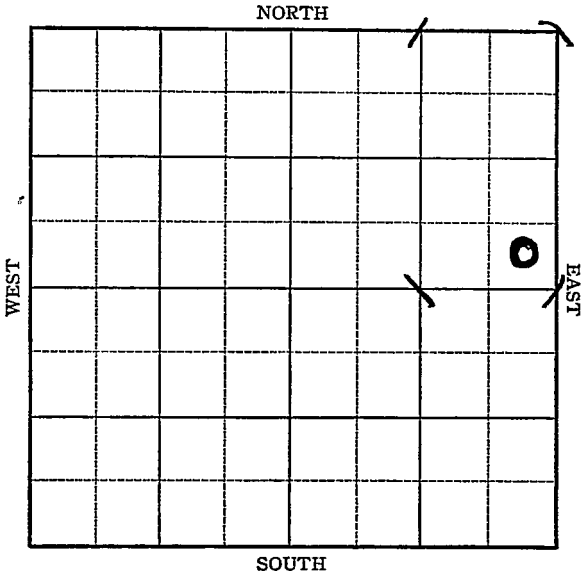


Ticket Rptd for T.D.

Form 252-A—5M—7-36—Palace KANSAS Ellis

Sec. 29 Twp. 11 R. 17-W

Well No. #1 Madden Est. Farm

Twin Drlg. Company

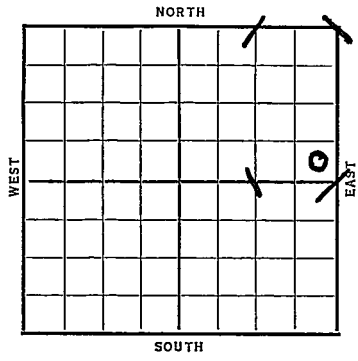

____ Ft. from N. Line

330 Ft. from S. Line

330 Ft. from E. Line

____ Ft. from W. Line

Elev. 2004

Date	REPORT
1937	
5/26	Mov. in rig.
6/4	15" @ 33'. Drlg. 1920'.
6/11	Drlg. 2910'.
6/19	Drlg. 3420'.
6/25	Sil. & 7" @ 3503'.
	T.D. 3521'. S. O.
7/2	Sil. 3538(Corrected)
	3100' oil in 10 hrs.
	Swab 10 bbls. per hr.
	500 acid.
7/9	T.D. 3548'. Cementing liner.
7/16	5" liner 3538'. 1000 acid.
	Swbg. 42 bbls. oil per hr.
7/21	7" @ 3503'
	5" liner 3538' T.D. 3548'.
	Sil 3538 (corrected)
	1000 acid
	Pump 371½/6 hrs
	Pot 1327
	COMPLETED

Form 26—1M Bks.—2-29 Ellis KANSAS

Map No. 71 Sec. 29 Twp. 11 R. 17W


Well No. 1- Madden East

Twin Oil Company

Contractor

FIRST REPORT

SECTION PLAT

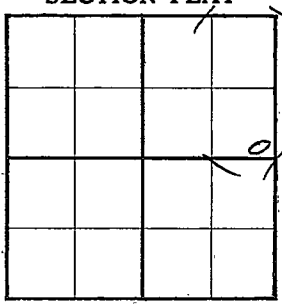

Ft. from N. Line

330 Ft. from S. Line

330 Ft. from E. Line

Ft. from W. Line

Location

Rig up

Drilling and Remarks:

Mov. in Rig

RECORD

Cased in., ft.

Sand

Gas

Oil

Total Depth

PRODUCTION

1st 24 hrs. Nat.

1st 24 hrs. after shot

Gas Cu. Ft.

Dry Hole

Abandoned

Date

MAY 26 1937 19

H. D. Hatfield Scout

Form 26—1M Bks.—2-29 Ellis KANSAS

Map No. 7 Sec. 29 Twp. 11 R. 17W

Well No. 1 - Madden East

Twin Drlg Company

Contractor

COMPLETED


Ft. from N. Line

330 Ft. from S. Line

330 Ft. from E. Line

Ft. from W. Line

SECTION PLAT

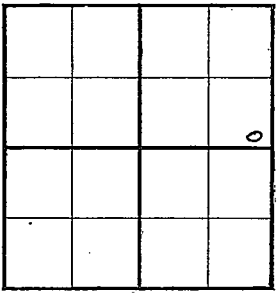

Location

Rig up

Drilling and Remarks:

1000 Acid

Pump 37 1/2 / 6 hrs

Pot - 1327

7" - 3503

RECORD

Cased 5" Liner 3538 in., ft.

~~Sand~~ Sil 3538 corrected

Gas

Oil

Total Depth 3548

PRODUCTION

1st 24 hrs. Nat.

1st 24 hrs. after shot

Gas Cu. Ft.

Dry Hole

Abandoned

Date

JUL 21 1937 19

H. D. Hatfield Scout