



Russell

Form 252A-5M-5-28-Mid-West

Map No. **KANSAS** Sec. 29 Twp. 11 R. 15<sup>w</sup>

Well No. 4 F Booth Farm

~~Mid-West~~ Company


Harold

330 Ft. from N. Line

..... Ft. from S. Line

..... Ft. from E. Line

990 Ft. from W. Line

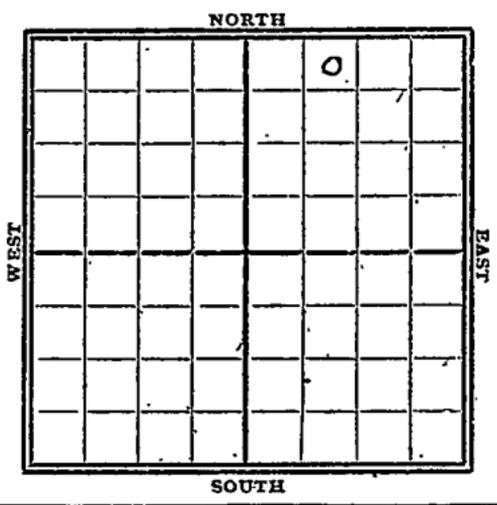

1928

Date REPORT **O. W. D. D**

Date	REPORT
11/21	Ro G.
11/28	<u>                    </u>
12/15	Bldg Rig
12/12	Rign up
12/19	Spud
12/26	drlg 465'
1929	
1/2	" 950'
1/9	" 1200'
1/16	run 8"-2410'
1/23	drlg 2510'
1/30	" 2575'
2/6	" 2670'
2/13	drlg 2911' 8"-2659'
2/20	Top Oswald 2930' show oil.
	HFV-2962 drlg 3024'
2/27	drlg 3087'
3/6	" 3097'
3/13	show oil 3133 drlg 3143' (over)

3/20 - Gorham sand  
from 3143-57'  
T.D. 3157'  
swab 22 1/2 bbl 24 hrs.  
Pump.

**O. W. D. D**

1926

6/10 - OLD TOTAL DEPTH 3157'  
GORHAM SAND 3252-53'  
~~T.D.~~ TOTAL DEPTH. 3253'  
Pot. 364 BBLS. OF 29 GRAVITY  
OIL. FIRST REPORTS  
and  
**COMPLETED**

*Russell*  
~~NO TRACING~~  
 MAP NO. KANSAS SEC. 29 TWP. 11 R. 15W

WELL NO. H. F. Booth

Mid West COMPANY

CONTRACTOR

SECTION PLAT

		D	

330 FT. FROM N. LINE

FT. FROM S. LINE

FT. FROM E. LINE

990 FT. FROM W. LINE

FIRST REPORTS

RECORD

LOCATION \_\_\_\_\_

CASED \_\_\_\_\_ IN. \_\_\_\_\_ FT.

RIG UP \_\_\_\_\_

SAND \_\_\_\_\_

DRILLING AND REMARKS:

GAS \_\_\_\_\_

OIL \_\_\_\_\_

TOTAL DEPTH \_\_\_\_\_

*ROG*

PRODUCTION

1ST 24 HRS. NAT. \_\_\_\_\_

1ST 24 HRS. AFTER SHOT \_\_\_\_\_

GAS \_\_\_\_\_ CU. FT.

DRY HOLE \_\_\_\_\_

ABANDONED \_\_\_\_\_

DATE

**NOV 21 1928**

192

**S. J. LEWIS** SCOUT

MAP No. KANSAS SEC. 29 TWP. 11 R. 15W

WELL No. Wm. F. Booth

Mich. West COMPANY

CONTRACTOR

SECTION PLAT

		0	

330 FT. FROM N. LINE

FT. FROM S. LINE

FT. FROM E. LINE

990 FT. FROM W. LINE

COMPLETED

LOCATION \_\_\_\_\_

RIG UP \_\_\_\_\_

DRILLING AND REMARKS:

*Goeham Sand  
3143 & 3157*

*swabbing  
2 1/2 hrs oil  
24 hrs*

RECORD

CASED \_\_\_\_\_ IN. \_\_\_\_\_ FT.

SAND \_\_\_\_\_

GAS \_\_\_\_\_

OIL \_\_\_\_\_

TOTAL DEPTH 3157

PRODUCTION

1ST 24 HRS. NAT. \_\_\_\_\_

1ST 24 HRS. AFTER SHOT \_\_\_\_\_

GAS \_\_\_\_\_ CU. FT.

DRY HOLE \_\_\_\_\_

ABANDONED \_\_\_\_\_

DATE

MAR 20 1929

S. J. LEWIS SCOUT

Map No. **KANSAS** Sec. 29 Twp. 11 R. 15

Well No. 4 Booth

Stanolind Company

CORRECTION Contractor

*Company name from  
mid west to Stanolind*

**SECTION PLAT**

		0	

330 Ft. from N. Line

\_\_\_\_\_ Ft. from S. Line

\_\_\_\_\_ Ft. from E. Line

990 Ft. from W. Line

**COMPLETED  
FIRST REPORTS**  
*OK*

Location \_\_\_\_\_

Rig up \_\_\_\_\_

Drilling and Remarks:

*Old T/D 3157  
Sokan Sand  
3253 - 53  
P 83648 ft.  
29° S.*

**RECORD**

Cased \_\_\_\_\_ in., \_\_\_\_\_ ft.  
Sand \_\_\_\_\_  
Gas \_\_\_\_\_  
Oil \_\_\_\_\_  
Total Depth 3253

**PRODUCTION**

1st 24 hrs. Nat. \_\_\_\_\_  
1st 24 hrs. after shot \_\_\_\_\_  
Gas \_\_\_\_\_ Cu. Ft.  
Dry Hole \_\_\_\_\_  
Abandoned \_\_\_\_\_

Date

JUN 10 1936

S. J. LEWIS Scout