


Section 3 Township 11 Range 17-W

Well No. #1 Simpson

Company Helmerich & Payne

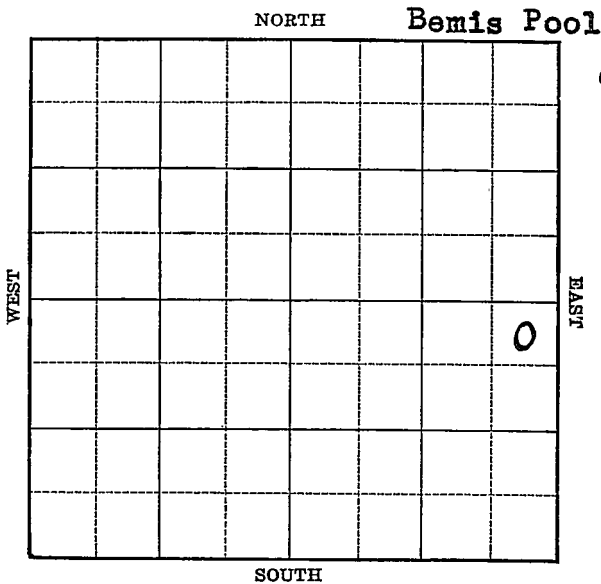


KANSAS

Ellis

Sec. 3 Twp. 11 R. 17-WWell No. #1 Simpson FarmHelmerich & Payne Company

(Bemis)

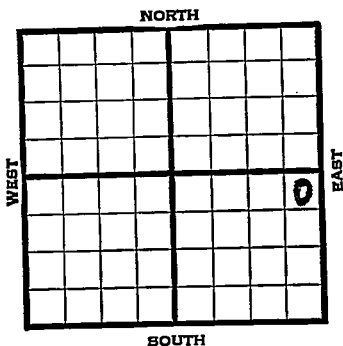330 Ft. from N. Line Ft. from S. Line330 Ft. from E. Line Ft. from W. Line

1939

REPORT

8/16

Drlg. 1300'

8/24

15" - 55' Drlg. 2840'

8/31

Lans. 3142' Drlg. 3405'

9/6

Cong. 3420'

Arb. 3510'

T.D. 3530'

No shows.

ABANDONED

KANSAS

Ellis

Map No. 71 Sec. 3 Twp. 11 R. 17WWell No. 1 SimpsonHelmerich & Payne Company

Contractor

FIRST REPORT,
NE SE

SECTION PLAT

330 Ft. from N. Line

Ft. from S. Line

330 Ft. from E. Line

Ft. from W. Line

			0

BEMIS POOL

Location _____

Rig up _____

Drilling and Remarks:

Dr lg. 1300

RECORD

Cased _____ in., _____ ft.

Sand _____

Gas _____

Oil _____

Total Depth _____

PRODUCTION

1st 24 hrs. Nat. _____

1st 24 hrs. after shot _____

Gas _____ Cu. Ft.

Dry Hole _____

Abandoned _____

Date

AUG 16 1939

19

S. J. LEWIS

Scout

Ellis

KANSAS

Map No. 71 Sec. 3 Twp. 11 R. 17WWell No. 1 SimpsonHelmerich & Payne Company

Contractor

ABANDONED

NE SE

330 Ft. from N. Line

Ft. from S. Line

330 Ft. from E. Line

Ft. from W. Line

BEMIS POOL

SECTION PLAT

			0

Location _____

Rig up _____

Drilling and Remarks:

*Core 3420**At 3510**No shows*

RECORD

Cased _____ in., _____ ft.

Sand _____

Gas _____

Oil _____

Total Depth 3530

PRODUCTION

1st 24 hrs. Nat. _____

1st 24 hrs. after shot _____

Gas _____ Cu. Ft.

Dry Hole _____

Abandoned _____

Date

SEP 6 1939 19

S. J. LEWIS Scout