

KANSAS

Ellis

Section 3 Township 11 Range 16W

Well No. 1 Dreilling

Company Cities Service

Krueger

NORTH

						0	

WEST

EAST

SOUTH

Ellis KANSAS ✓

Sec. 3 Twp. 11 R. 16W

Well No. #1 Dreilling Farm

Cities Service

Company

Krueger Pool (Holmes, Cont.) NORTH


330' Ft. from N. Line

 Ft. from S. Line

990' Ft. from E. Line

 Ft. from W. Line

NW NE NE'

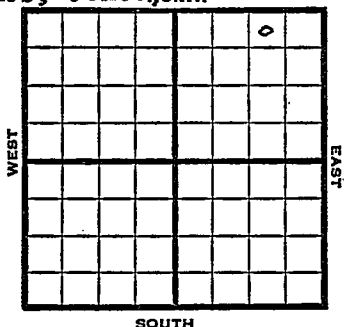

1949

Elev 2062' REPORT

5/25 Location
6/1 8" @ 302'
Drlg 1280'
6/7 Lansing 3234'
TD 3523'
5" @ 3523'
6/15 "
6/21 "
6/28 "
7/6 164 shots 3205-3293 - 4500 acid
Pump 245 oil & 58 W in 13 hrs.
7/12 TD 3523'
Lans 3234'
5" @ 3523'
Perf 4500 acid
Pump 690 Oil & 3% W Pot
27° Gr.
omp
COMPLETED

Map No. _____ Sec. 3 Twp. 11 R. 16W

Well No. 1 Dreilling

Cities Service Company

Holmes Contractor

NW NE NE


**FIRST REPORT
SECTION PLAT**

330 Ft. from N. Line

_____ Ft. from S. Line

990 Ft. from E. Line

_____ Ft. from W. Line

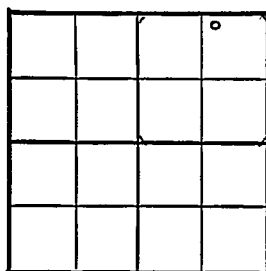

Ellis County

Location X

Rig up _____

Drilling and Remarks: -

RECORD

Cased _____ in., _____ ft.

Sand _____

Gas _____

Oil _____

Total Depth _____

PRODUCTION

1st 24 hrs. Natl. _____

1st 24 hrs. after shot _____

Gas _____ Cu. Ft.

Dry Hole _____

Abandoned _____

Date

MAY 25 1949 19

S. J. LEWIS

Scout

Kansas

Krueger Pool

Map No. K71 Sec. 3 Twp. 11 R. 16WWell No. 1 Dreiling

Cities Service

Company

COMPLETE

Contractor

NW NE NE

E12062
SECTION PLAT330 Ft. from N. Line Ft. from S. Line990 Ft. from E. Line Ft. from W. Line

			0

Ellis County

Location Rig up

Drilling and Remarks:

Loss 32345" C3523Prof.4500 acidProf 690 oil + 35% H₂OProf27% oil

RECORD

Cased in., ft.Sand Gas Oil Total Depth 2529

PRODUCTION

1st 24 hrs. Nat. 1st 24 hrs. after shot Gas Cu. Ft.Dry Hole Abandoned

Date

JUL 13 1949S. J. LEWIS

Scout