

KANSAS


Ellis

FORM 51 5M, 1-42 PETROL

Section 3 Township 11 Range 19-W

Well No. #1 Falconberry

Company Phil-Han & Nat'l Ref

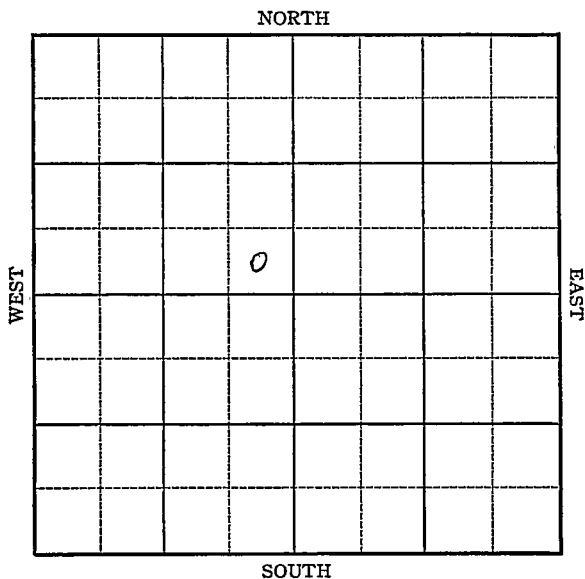

KANSAS


Ellis

Sec. 3 Twp. 11 R. 19-W

Well No. #1 Falconberry Farm

Phil-Han & Nat'l Ref. Company

NORTH

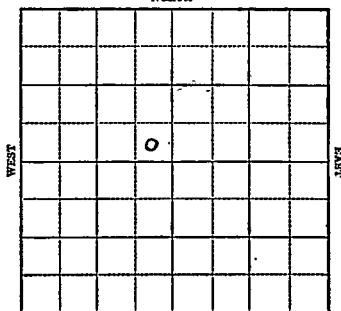

SOUTH

 Ft. from N. Line

330 Ft. from S. Line

330 Ft. from E. Line

 Ft. from W. Line

Elev. 2062

1943

R E P O R T

9/29 Location

10/6 10" @ 210'
WOC.

10/13 Anhy 1482
Drlg. 2230'

10/20 Drlg. 3295
Lans 3242


10/27 Lans 3263
Cong 3521
T.D. 3615'

ABANDONED

KANSASMap No. 70 Sec. 3 Twp. 11 R. 19WWell No. 1 FalconberryPhil-Han & Nat'l Ref. Company**FIRST REPORT**

Contractor

SE NW

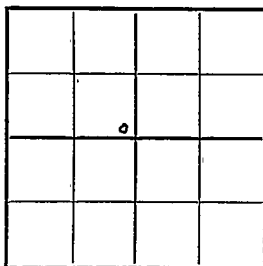SECTION PLAT Ft. from N. Line330 Ft. from S. Line330 Ft. from E. Line Ft. from W. Line**Wildcat**Location XRig up

Drilling and Remarks:

RECORDCased in., ft.Sand Gas Oil Total Depth **PRODUCTION**1st 24 hrs. Nat. 1st 24 hrs. after shot Gas Cu. Ft.Dry Hole Abandoned

Date

SEP 29 194319S. J. LEWIS

Scout

KANSAS
 Map No. 70 Sec. 3 Twp. 11 R. 19W

Well No. 1 Falconberry


Phil-Han & Nat'l Ref. Company

ABANDONED

Contractor

SE NW

SECTION PLAT

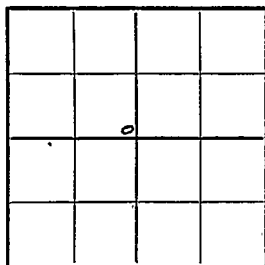

 Ft. from N. Line

330 Ft. from S. Line

330 Ft. from E. Line

 Ft. from W. Line

Wildcat

Location

Rig up

Drilling and Remarks:

Have 3263

Core 3521

3615 in Core

RECORD

Cased in., ft.

Sand

Gas

Oil

Total Depth 3615

PRODUCTION

1st 24 hrs. Nat.

1st 24 hrs. after shot

Gas Cu. Ft.

Dry Hole

Abandoned

Date

OCT 27 1943

19

S. J. LEWIS Scout