

Section 3 Township 11 Range 18W

Well No. #5 Farm Mortgage

Company Continental

Burnett Poeb

NORTH

WEST

EAST

						0	

SOUTH

KANSAS

Ellis

Sec. 3 Twp. 11 R. 18W

Well No. #5 Farm Mortgage Farm

Continental Company


Burnett Pool

 Ft. from N. Line

1115' Ft. from S. Line

931' Ft. from E. Line

 Ft. from W. Line

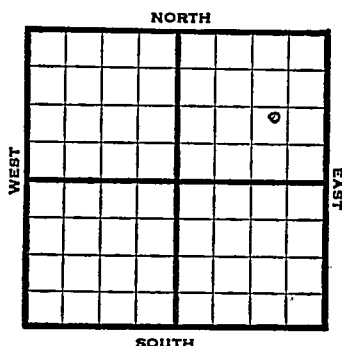

1948 Elev. 2079' REPORT

2/18	Location
2/25	10" @ 204'
	Drlg. 1385'
3/3	Drlg. 3054'
3/10	Arbuckle 3615'
	TD 3622'
	6" @ 3616'
	RUST
3/17	Lansing 3387'
3/24	"
3/31	1500' oil 1 hr.
4/7	Arbuckle 3615'
	6" @ 3616'
	Echo Pot. 3000
	Gr. 37°
	TD 3623'

COMPLETED

Map No. _____ Sec. 3 Twp. 11 R. 18W

Well No. 5 Farm Mortgage

Continental

Company

FIRST REPORT

Contractor

NW SE NE

SECTION PLAT

			o

_____ Ft. from N. Line

1115 Ft. from S. Line

931 Ft. from E. Line

_____ Ft. from W. Line

Ellis County

Location X

Rig up _____

Drilling and Remarks:

RECORD

Cased _____ in., _____ ft.

Sand _____

Gas _____

Oil _____

Total Depth _____

PRODUCTION

1st 24 hrs. Nat. _____

1st 24 hrs. after shot _____

Gas _____ Cu. Ft.

Dry Hole _____

Abandoned _____

Date

FEB 18 1948

19

S. J. LEWIS

Scout

Map No. 71 Sec. 3 Twp. 11 R. 18W

Well No. 5 Farm Mortgage

Continental Company

COMPLETE

Contractor

NW SE NE

E 12078
SECTION PLAT

 Ft. from N. Line

1115 Ft. from S. Line

931 Ft. from E. Line

 Ft. from W. Line

			0

Ellis County

Location

Rig up

Drilling and Remarks:

Per Y3615

6" @ 3616

Ecl to P 43000

37 2/3

RECORD

Cased in., ft.

Sand

Gas

Oil ✓

Total Depth 3623

PRODUCTION

1st 24 hrs. Nat.

1st 24 hrs. after shot

Gas Cu. Ft.

Dry Hole

Abandoned

Date

APR 7 1948 19 S. J. LEWIS Scout