


Section - 3 Township 11 Range 18 W

Well No. # 1 Meistrell

Company G-M-R Oil

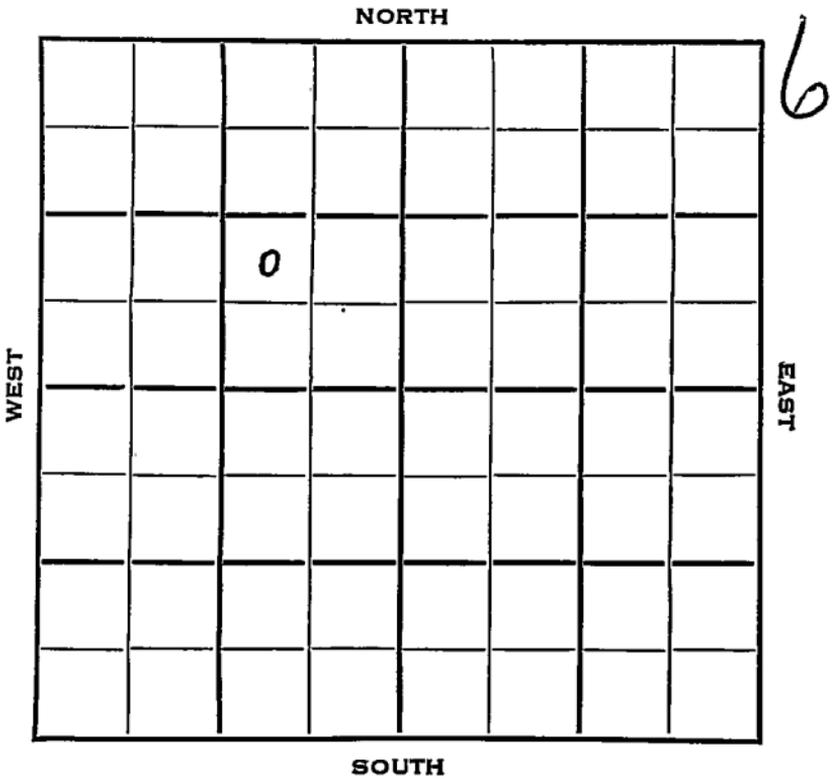


Sec. 3 Twp. 11 R. 18WWell No. #1 Meistrell FarmG-M-R Oil CompanyG-M-R ContractorMeistrell Pool

Ft. from N. Line

990 Ft. from S. Line990 Ft. from E. Line

Ft. from W. Line

NW SE NW

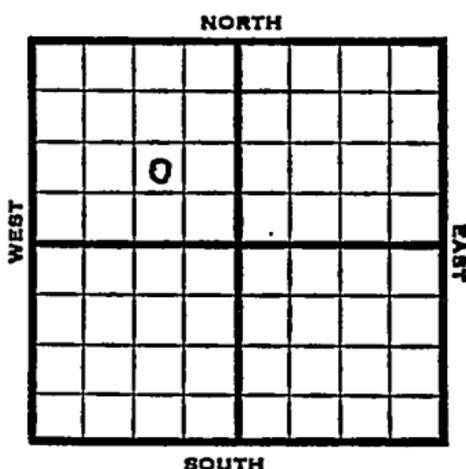

1953 Elev. 1974' REPORT

7/1 Spud 6-28-53

8" @ 190

Drlg. 1247'

7/8 Heeb 3179, Tor 3200, Lans 3222.

Drlg 3242'

7/15 Spud 6-28-53 D & A TD 3560
8" @ 190 Heeb 3179 Tor. 3200
Lans. 3222DST 3296-3320 open 1 hr rec 535' SW
1000# Cong 3464 Simp 3518

Arb. 3541

DST 3542-47 open $\frac{1}{2}$ hr rec 10' mudDST 3547-53 open $\frac{1}{2}$ hr. rec 10' mud
410#DST 3553-60 open 1 hr rec 120' SW
780#

D & A

ABANDONED

County Ellis State Kansas

Sec. 3 (Blk. 11) (Sur. Rge.) 18W Map No.

Operator G-M-R Oil

Well No. 1 Farm Meistrell

Elev. Location NW SE NW

990 Ft. From S Line NW

990 Ft. From E Line Quarter

1st. Report JUL 1 1953

Completion

Remarks

G-M-R - Contr.

Spudding Date 6-28-53

Drlg. Data Meistrell Pool

8" @ 190 drlg. 1247

