


Section 3 Township 11 Range 18W

Well No. 4 Meistrell

Company El Dorado Ref.

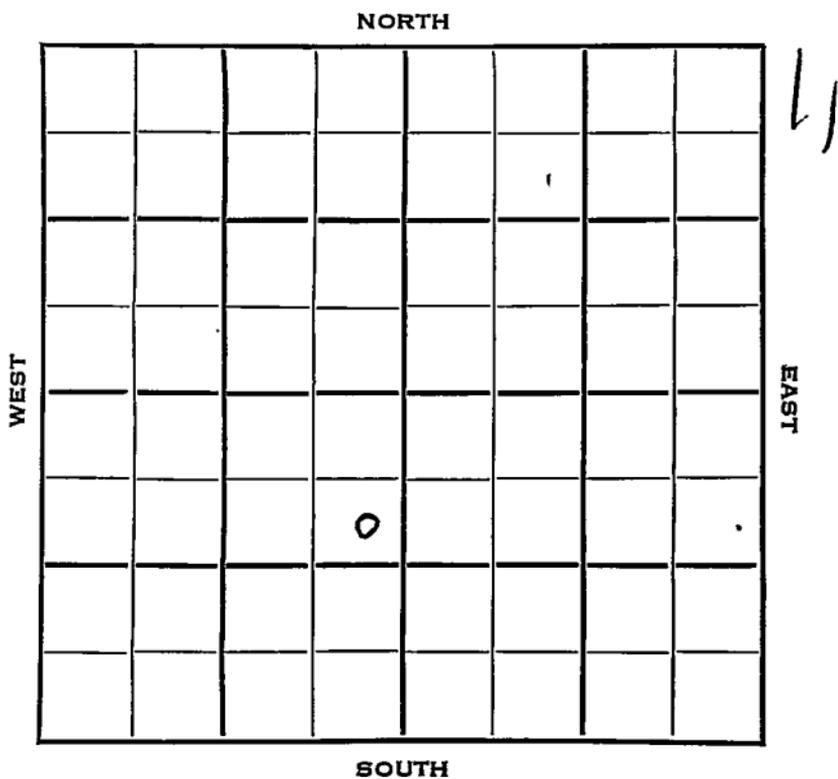


SEC.	TWP.	R.
3	11	KANSAS 18 W ✓

WELL NO. _____
 # 1 Meistrell FARM
 COMPANY _____

El Dorado Ref.
 CONTRACTOR _____

Anschutz
 NW Burnett Pool
 920 _____ Ft. from N. Line
 _____ Ft. from S. Line
 280 _____ Ft. from E. Line
 _____ Ft. from W. Line

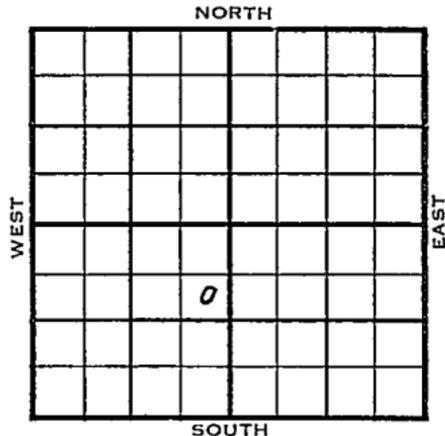

SE NE SW

	ELEVATION	REPORT
1954	2019'	

1/13 Spud 1-9-54
 8" @ 480 WOC

1/20 Anhy 1360', Heeb 3245', Lans 3288'
 Drlg. 3432'

1/27 Cong. 3521' Simp 3595' Arb. 3621'
 DST 3621-27, 1 hr, 80' wtr, 1060#
 RTD 3875' 5" @ 3670

2/3 Spud 1-9-54 8" @ 480
 Anhy 1360 Heeb 3245 Lans 3288
 Cong. 3521 Simp 3595 Arb. 3621
 DST 3621-27 open 1 hr rec 80' wtr.
 1060# TD 3875 5" @ 3670
 CO to 3875 1000 A
 Comp. for SWD well TD 3875

ABANDONED

County Ellis State Kansas

Sec. 3 (Blk.) 11 (Sur.) 18W Map No.

Operator Eldorado Ref.

Well No. 4 Farm Meistrell

Elev. _____ Location SE NE SW

FIRST REPORT					

920 Ft. From II Line SW

280 Ft. From II Line Quarter

Ist. Report JAN 13 1954

Completion _____

Remarks _____

Anschutz - Contr.

Spudding Date 1-9-54

Drlg. Data NW Burnett Pool

8" @ 480 WOC

County Ellis State Kansas

Sec. 3 (Blk. Twp.) 11 (Sur. Rge.) 18W Map No.

Operator Eldorado Ref.

Well No. 4 Farm Meistrell

Elev. 2049 Location SE NE SW

ABANDONED					

920 Ft. From N Line SW

280 Ft. From E Line Quarter

1st. Report

Completion FEB 3 1954

Remarks NW Burnett Pool

Anschutz - Contr.

Spudding Date 1-9-54

Drlg. Data

8" @ 480 Anhy 1360 Heeb. 3245

Lans. 3288 Cong. 3521 Simp. 3595

Arb. 3621 DST 3621-27 open 1 hr.

Rec. 80' wtr. 1060# TD 3875

5" @ 3670 CO to 3875 1000 A

Comp. for SWD well TD 3875

I. G. McGEHEE